

STATE OF KANSAS
STATE CORPORATION COMMISSION
200 Colorado Derby Building
Wichita, Kansas 67202

WELL PLUGGING RECORD
K.A.R.-82-3-117

API NUMBER 15-101-21,504-0000

LEASE NAME Borell C

WELL NUMBER 1

330 Ft. from S Section Line

2970 Ft. from E Section Line

SEC. 9 TWP. 18 RGE. 27 ~~CS~~ or (W)

COUNTY Lane

Date Well Completed 3/17/89

Plugging Commenced 3/17/89

Plugging Completed 3/17/89

TYPE OR PRINT
NOTICE: Fill out completely
and return to Cons. Div.
office within 30 days.

LEASE OPERATOR Blue Goose Drilling Co., Inc.

ADDRESS P.O. Box 1413, Great Bend, KS 67530

PHONE#(316) 792-5633 OPERATORS LICENSE NO. 5104

Character of Well D & A

(Oil, Gas, D&A, SWD, Input, Water Supply Well)

The plugging proposal was approved on 3/16/89 (date)

by Dick Kapp (KCC District Agent's Name).

Is AC0-1 filed? yes If not, is well log attached? _____

Producing Formation _____ Depth to Top _____ Bottom _____ T.D. 4633'

Show depth and thickness of all water, oil and gas formations.

OIL, GAS OR WATER RECORDS

CASING RECORD

RECEIVED

STATE CORPORATION COMMISSION
5 19 89
MAY 19 1989

Formation	From	To	Size	Put in	Pulled out
			8 5/8"	203	0

Describe in detail Wichita, Kansas in which the well was plugged, indicating where the mud fluid was placed and the method or methods used in introducing it into the hole. If cement or other plugs were used, state the character of same and depth placed, from feet to feet each set.

40 sx @ 2092' 10 sx @ 40'
90 sx @ 1300' 15 sx @ rathole 60/40 posmix 6% gel
50 sx @ 230'

(If additional description is necessary, use BACK of this form.)

Name of Plugging Contractor Blue Goose Drilling Co., Inc. License No. 5104

Address same

NAME OF PARTY RESPONSIBLE FOR PLUGGING FEES: Operator


STATE OF KANSAS COUNTY OF BARTON, ss.

Martin E. Miller (Employee of Operator) or (~~Operator~~) of

above-described well, being first duly sworn on oath, says: That I have knowledge of the facts, statements, and matters herein contained and the log of the above-described well, as filed that the same are true and correct, so help me God.

(Signature) Martin E. Miller

(Address) P.O. Box 1413, Great Bend, KS 67530

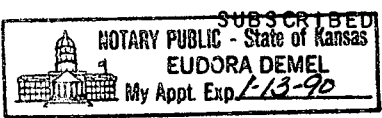

SUBSCRIBED AND SWORN TO before me this 17th day of May, 19 89

Eudora Demel
Notary Public

My Commission Expires: 1-13-90

101-21,504-0000

FORM MUST BE TYPED
FORM C-1, 12/88

State of Kansas
NOTICE OF INTENTION TO DRILL

FORM MUST BE SIGNED
ALL BLANKS MUST BE FILLED

Must be approved by the K.C.C. five (5) days prior to commencing well

Expected Spud Date March 7, 1989
month day year

SE SE SW Sec 9 Twp 18 S, Rg 27 East
X West

OPERATOR: License # 5104
Name: Blue Goose Drilling Co., Inc.
Address: P.O. Box 1413
City/State/Zip: Great Bend, KS 67530
Contact Person: Martin Miller
Phone: 316 792-5633

330 feet from South line of Section
2970 feet from East line of Section
(Note: Locate well on Section Plat Below)

CONTRACTOR: License #: same
Name: company tools

County: Lane
Lease Name: Borell C Well #: 1
Field Name: Alamota NW

Well Drilled For: Well Class: Type Equipment:
 Oil ... Inj ... Infield Mud Rotary
 Gas ... Storage Pool Ext. ... Air Rotary
 OWWO ... Disposal ... Wildcat ... Cable
 Seismic; ... # of Holes

Is this a Prorated field? ... yes no
Target Formation(s): Mississippi
Nearest lease or unit boundary: 330
Ground Surface Elevation: 2685 feet MSL
Domestic well within 330 feet: ... yes no
Municipal well within one mile: ... yes no
Depth to bottom of fresh water: 100' 150'
Depth to bottom of usable water: 1250'
Surface Pipe by Alternate: ... 1 2
Length of Surface Pipe Planned to be set: 200'
Length of Conductor pipe required: n/a
Projected Total Depth: 4650'
Formation at Total Depth: Mississippi
Water Source for Drilling Operations:
 well ... farm pond ... other

If OWWO: old well information as follows:
Operator: _____
Well Name: _____
Comp. Date: _____ Old Total Depth _____

DWR Permit #: 34539
Will Cores Be Taken? ... yes no
If yes, proposed zone: _____

Directional, Deviated or Horizontal wellbore? ... yes no
If yes, total depth location: _____


Spud: 3-7-89 200 + 858 Haltwater 200' act. 2 Reg.

AFFIDAVIT

PUSHER Martin Miller
TD 4633 FORMATION Mus
SURFACE PIPE 8 1/8 @ 210' 1355x
2060
ANHYDRITE 2092 ELEVATION 2697
STARTING TIME & DATE 5:00 AM
3-17-89
COMPLETION TIME & DATE 9:30 AM
1st PLUG @ 2092 FT. W/ 40 SX
2nd PLUG @ 1800 FT. W/ 90 SX
3rd PLUG @ 170 FT. W/ 50 SX
4th PLUG @ 40 FT. W/ 10 SX
RAT HOLE CIRCULATED W/ 15 SX
MOUSE HOLE CIRCULATED W/ 10 SX
WATER WELL PLUGGED W/ _____ SX
CEMENT COMPANY? Haltwater
TECHNICIAN _____

RECEIVED
STATE CORPORATION COMMISSION
MAR 23 1989
CONSERVATION DIVISION
Wichita, Kansas

60/40 Perm 6 to 9-0

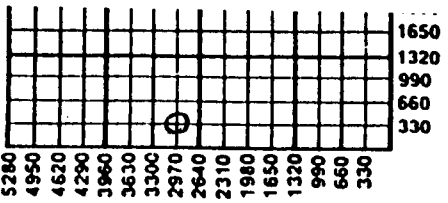

Wichita, Kansas _____

REMEMBER TO:

- File Drill Pit Application (form CDP-1) with Intent to Drill;
- File Completion Form ACO-1 within 120 days of spud date;
- File acreage attribution plat according to field prorated orders;
- Notify appropriate district office 48 hours prior to workover or re-entry;
- Submit plugging report (CP-4) after plugging is completed;
- Obtain written approval before disposing or injecting salt water.