


STATE OF KANSAS  
STATE CORPORATION COMMISSION

WELL PLUGGING RECORD

Give All Information Completely  
Make Required Affidavit  
Mail or Deliver Report to  
Conservation Division  
State Corporation Comm.  
245 North Water  
Wichita, KS 67202

Lane \_\_\_\_\_ County. Sec. 9 Twp. 18S Rge. 27W E/W  
Location as "NE/CNW/SW" or footage from lines  
SW NW NW

Lease Owner Beren Corporation  
Lease Name Donna Well No. #1  
Office Address 970 Fourth Financial Center, Wichita, Ks. 67202  
Character of Well (Completed as Oil, Gas or Dry Hole) \_\_\_\_\_

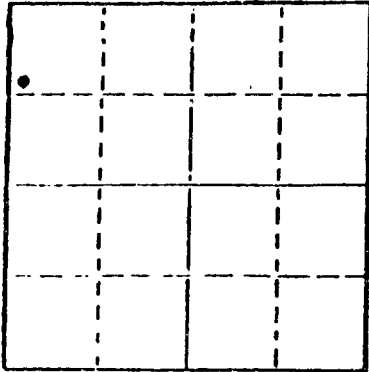

Dry Hole  
Date Well completed May 11, 19 82  
Application for plugging filed May 11, 19 82  
Application for plugging approved May 11, 19 82  
Plugging commenced May 11, 19 82  
Plugging completed May 11, 19 82  
Reason for abandonment of well or producing formation \_\_\_\_\_  
Dry Hole

If a producing well is abandoned, date of last production 19 \_\_\_\_\_

Was permission obtained from the Conservation Division or its agents before plugging was commenced? Yes

Name of Conservation Agent who supervised plugging of this well Steve Durant  
Producing formation \_\_\_\_\_ Depth to top \_\_\_\_\_ Bottom \_\_\_\_\_ Total Depth of Well \_\_\_\_\_  
Show depth and thickness of all water, oil and gas formations.

OIL, GAS OR WATER RECORDS

CASING RECORD

FORMATION	CONTENT	FROM	TO	SIZE	PUT IN	PULLED OUT

Describe in detail the manner in which the well was plugged, indicating where the mud fluid was placed and the method or methods used in introducing it into the hold. If cement or other plugs were used, state the character of same and depth placed, from \_\_\_\_\_ feet to \_\_\_\_\_ feet for each plug set.

Cement 50-50 Pozmix, 4% Gel, 3% CC

- 70 sks @ 1140'
- 30 sks @ 300'
- 10 sks @ 40' Hulls & Plug
- 10 sks Mouse Hole
- 10 sks Rat Hole

RECEIVED  
STATE CORPORATION COMMISSION  
5-17-82  
MAY 17 1982

Complete 2:30 P.M. 5/11/82


(If additional description is necessary, use BACK of this sheet)

Name of Plugging Contractor Sun Cementing

CONSERVATION DIVISION  
Wichita Kansas

STATE OF Kansas COUNTY OF Sedgwick, ss.  
Jerome D. Marcus (employee of owner) or (owner or operator)

of the above-described well, being first duly sworn on oath, says: That I have knowledge of the facts, statements, and matters herein contained and the log of the above-described well as filed and that the same are true and correct. So help me God.

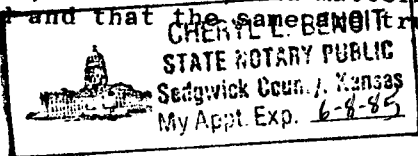

(Signature)

401 E. Douglas, Suite 402, Wichita, Kansas 67202

(Address)

SUBSCRIBED AND SWORN TO before me this 14th day of May, 19 82

Cheryl L. Benoit

Notary Public.

My commission expires June 8, 1985