


STATE OF KANSAS
STATE CORPORATION COMMISSION

Form CP-4

WELL PLUGGING RECORD

Give All Information Completely
Make Required Affidavit
Mail or Deliver Report to:
Conservation Division
State Corporation Commission
P. O. Box 17027

Wichita, Kansas 67217
NORTH

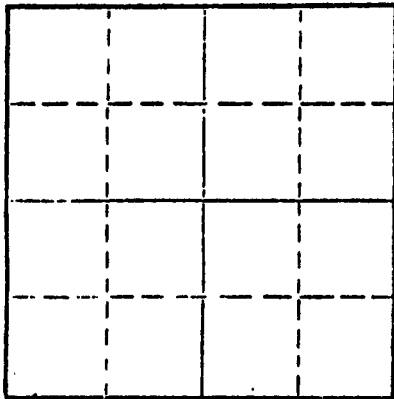

Locate well correctly on above
Section Plat

Ness County, Sec. 21 Twp. 16S Rge. 23W (E) (W)
Location as "NE/CNW&SW" or footage from lines. NW SE NE
Lease Owner Palomino Petroleum
Lease Name Scherzinger "B" Well No. #1
Office Address 500 Insurance Building, Wichita, Kansas 67202
Character of Well (completed as Oil, Gas or Dry Hole) dry hole
Date well completed November 18, 1979 19
Application for plugging filed November 18, 1979 19
Application for plugging approved November 18, 1979 19
Plugging commenced November 18, 1979 19
Plugging completed November 18, 1979 19
Reason for abandonment of well or producing formation dry hole

If a producing well is abandoned, date of last production 19
Was permission obtained from the Conservation Division or its agents before plugging was commenced? yes

Name of Conservation Agent who supervised plugging of this well Marion Schmidt
Producing formation Depth to top Bottom Total Depth of Well 4490' Feet
Show depth and thickness of all water, oil and gas formations.

OIL, GAS OR WATER RECORDS

CASING RECORD

FORMATION	CONTENT	FROM	TO	SIZE	PUT IN	PULLED OUT

Describe in detail the manner in which the well was plugged, indicating where the mud fluid was placed and the method or methods used in introducing it into the hole. If cement or other plugs were used, state the character of same and depth placed, from feet to feet for each plug set.

Hole plugged with 50-50 pozmix, 6% gel as follows:
70 sacks @ 925'; 20 sacks @ 170'; hulls and 10 sacks @ 40'. Job completed
at 2:15 p.m., November 18, 1979.

RECEIVED
NOV 25 1979
11-29-79
CONSERVATION DIVISION

(If additional description is necessary, use BACK of this sheet)

Name of Plugging Contractor Strata Drilling Company
Address P. O. Box 355, Great Bend, Kansas 67530

STATE OF KANSAS COUNTY OF BARTON, ss.
Charles W. Steincamp

(employee of owner) or (owner or operator) of the above-described well, being first duly sworn on oath, says: That I have knowledge of the facts, statements, and matters herein contained and the log of the above-described well as filed and that the same are true and correct. So help me God.

(Signature) Charles W. Steincamp
P. O. Box 355, Great Bend, Kansas 67530
(Address)

Subscribed and sworn to before me this 26th day of November 19 79

My commission expires 3-28-80.



Loneita Barry
Notary Public.

15-135-21717-0000

D R I L L E R S L O G

#1 Scherzinger "B"

CASING RECORD:
7 jts. new 20#
8-5/8" surface
casing

COMPANY: Palomino Petroleum
CONTRACTOR: Strata Drilling Company
COMMENCED: November 10, 1979
COMPLETED: November 18, 1979

DESCRIPTION: NW SE NE
Section 21-16S-23W
Ness County, Kansas
ELEVATION: 2469' KB

TOTAL ROTARY
DEPTH: 4490'

D & A

<u>FORMATION</u>	<u>FROM</u>	<u>TO</u>	<u>REMARKS</u>
Post rock, shale	0	300	Ran 283' of new 20# 8-5/8" casing, set and cemented at 288' with 180 sacks common cement, 2% gel, 3% C.C. Cement circulated. Plug down at 10:15 p.m., November 10, 1979.
Shale, sand, shale	300	1808	
Anhydrite	1808	1845	
Shale and shells	1845	2480	
Lime and shale	2480	4442	
Lime	4442	4490	Ran 3 drill stem tests.
			Ran 1 electric log.
			Hole plugged with 50-50 pozmix, 6% gel, as follows: 70 sacks @ 925', 20 sacks @ 170', hulls and 10 sacks @ 40'. Job completed at 2:15 p.m., November 18, 1979.

STATE OF KANSAS)
)ss
COUNTY OF BARTON)

I hereby certify that this is a true and correct copy of the above log to the best of my knowledge.

STRATA DRILLING COMPANY

Charles W. Steincamp
Charles W. Steincamp

Sworn to and subscribed before me this 26th day of November, 1979.

my appointment expires 3-28-80.

Loneita Barry
Loneita Barry, Notary Public

