

STATE OF KANSAS
STATE CORPORATION COMMISSION

WELL PLUGGING RECORD

15-135-21534-0000

Give All Information Completely
Make Required Affidavit
Mail or Deliver Report to
Conservation Division
State Corporation Comm.
245 North Water
Wichita, KS 67202

Ness County, Sec. 21 Twp. 16S Rge. 23W E/W
Location as "NE/CNW $\frac{1}{4}$ /SW $\frac{1}{4}$ " or footage from lines
NW SE


Lease Owner Beren Corporation
Lease Name Baer Well No. #1
Office Address 970 Fourth Financial Center, Wichita, Kansas
Character of Well (Completed as Oil, Gas or Dry Hole)
dry hole

Date Well completed November 28, 1978 19
Application for plugging filed November 28, 1978 19
Application for plugging approved November 28, 1978 19
Plugging commenced November 28, 1978 19
Plugging completed November 28, 1978 19
Reason for abandonment of well or producing formation
dry hole

If a producing well is abandoned, date of last production
19

Was permission obtained from the Conservation Division or
its agents before plugging was commenced? yes

Name of Conservation Agent who supervised plugging of this well Leo Massey
Producing formation _____ Depth to top _____ Bottom _____ Total Depth of Well 4550'
Show depth and thickness of all water, oil and gas formations.

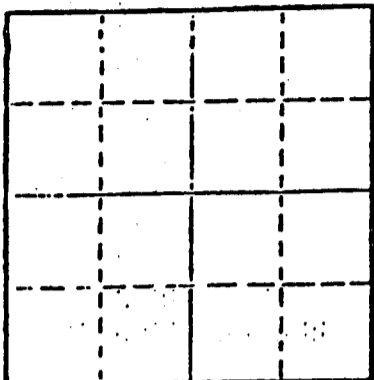

Locate well correctly on above.
Section Plat

OIL, GAS OR WATER RECORDS

CASING RECORD

FORMATION	CONTENT	FROM	TO	SIZE	PUT IN	PULLED OUT

Describe in detail the manner in which the well was plugged, indicating where the mud fluid was placed and the method or methods used in introducing it into the hold. If cement or other plugs were used, state the character of same and depth placed, from _____ feet to _____ feet for each plug set. Hole plugged with 50-50 pozmix, 6% salt, as follows: 70 sacks @ 810', 20 sacks @ 300', hulls and 10 sacks @ 40'. Plugging completed at 6:30 p.m., November 28, 1978.

RECEIVED
STATE CORPORATION COMMISSION

DEC 12 1978
12-12-78
CONSERVATION DIVISION
WICHITA, KANSAS

(If additional description is necessary, use BACK of this sheet)

Name of Plugging Contractor Strata Drilling Company


STATE OF KANSAS COUNTY OF BARTON, ss.
Kenneth J. Link (employee of owner) or (owner or operator)
of the above-described well, being first duly sworn on oath, says: That I have knowledge of the facts, statements, and matters herein contained and the log of the above-described well as filed and that the same are true and correct. So help me God.

(Signature) Kenneth J. Link President
P. O. Box 355, Great Bend, Kansas 67530
(Address)

SUBSCRIBED AND SWORN TO before me this 8th day of December, 1978

Loneita Barry
Loneita Barry Notary Public.

My commission expires 3-28-80.

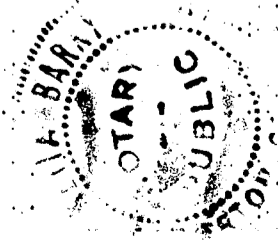

D R I L L E R S L O G

15-135-21534-0850

Baer #1

CASING RECORD:
8 jts. used 8-5/8"
surface casing

COMPANY: Beren Corporation
CONTRACTOR: Strata Drilling Company

DESCRIPTION: NW SE
Section 21-16S-23W
Ness County, Kansas

TOTAL ROTARY
DEPTH: 4550'

COMMENCED: November 22, 1978

COMPLETED: November 28, 1978

D & A

<u>FORMATION</u>	<u>FROM</u>	<u>TO</u>	<u>REMARKS</u>
Post rock, shale	0	345	Ran 327' used 8-5/8" surface casing; set and cemented @ 332' with 150 sacks 60-40 pozmix, and 50 sacks common cement. Cement circulated. Plug down 4:15 a.m., November 22, 1978.
Shale, sand, shale	345	1824	
Anhydrite	1824	1860	
Shale	1860	2415	
Lime and shale	2415	4300	
Lime	4300	4380	
Lime and shale	4380	4475	
Lime	4475	4550	Ran one drill stem test.
			Ran one electric log.
			Hole plugged with 50-50 pozmix, 6% salt, as follows: 70 sacks @ 810', 20 sacks @ 300', hulls and 10 sacks @ 40'. Plugging completed at 6:30 p.m., November 28, 1978.

RECEIVED
STATE CORPORATION COMMISSION

DEC 12 1978

CONSERVATION DIVISION
Wichita, Kansas

STATE OF KANSAS)
)ss
COUNTY OF BARTON)

I certify that this is a true and correct copy of the above log to the best of my knowledge.

STRATA DRILLING COMPANY

Kenneth J. Link
Kenneth J. Link, President

Sworn to and subscribed before me this 8th day of December, 1978.

My appointment expires 3-28-80.

Loneita Barry
Loneita Barry, Notary Public

