

STATE OF KANSAS
STATE CORPORATION COMMISSION

Give All Information Completely
Make Required Affidavit
Mail or Deliver Report to:
Conservation Division
State Corporation Commission
211 No. Broadway
Wichita, Kansas

WELL PLUGGING RECORD

Loc. Ness County. Sec. 26 Twp. 16S Rge. 23W (E) (W)

Location as "NE/CNW/SW" or footage from lines C SW NW

Lease Owner Imperial Oil Company

Lease Name Robinson Well No. 1

Office Address 780 Fourth Natl. Bldg., Wichita, Ks.

Character of Well (completed as Oil, Gas or Dry Hole) dry hole

Date well completed 5/7/63 19

Application for plugging filed 5/7/63 19

Application for plugging approved 5/7/63 19


Plugging commenced 5/7/63 19

Plugging completed 5/7/63 19

Reason for abandonment of well or producing formation
No commercial quantities of oil found

If a producing well is abandoned, date of last production _____ 19

Was permission obtained from the Conservation Division or its agents before plugging was commenced? Yes

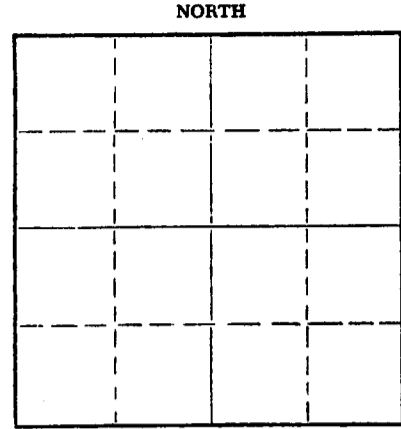

Locate well correctly on above
Section Plat

Name of Conservation Agent who supervised plugging of this well Eldon Petty, Hays, Kansas

Producing formation _____ Depth to top _____ Bottom _____ Total Depth of Well 4532 Feet

Show depth and thickness of all water, oil and gas formations.

OIL, GAS OR WATER RECORDS

CASING RECORD

FORMATION	CONTENT	FROM	TO	SIZE	PUT IN	PULLED OUT
	Surface casing	8-5/8"	at 318'	not	pulled	

Describe in detail the manner in which the well was plugged, indicating where the mud fluid was placed and the method or methods used in introducing it into the hole. If cement or other plugs were used, state the character of same and depth placed, from _____ feet to _____ feet for each plug set.

Set first plug at 550' with 20 sacks cement

Set second plug at 300' with 15 sacks cement

Set top plug at 40' with 10 sacks cement

RECEIVED
STATE CORPORATION COMMISSION
MAY 21 1963
5-21-63
CONSERVATION DIVISION
Wichita, Kansas

(If additional description is necessary, use BACK of this sheet)
Name of Plugging Contractor Imperial Oil of Kansas, Inc.
Address Box 97, WaKeeney, Kansas

STATE OF KANSAS, COUNTY OF SEDGWICK, ss.

John Lehman (employee of owner) or (owner or operator) of the above-described well, being first duly sworn on oath, says: That I have knowledge of the facts, statements, and matters herein contained and the log of the above-described well as filed and that the same are true and correct. So help me God.

(Signature) John Lehman
780 Fourth National Bldg., Wichita, Ks.
(Address)

SUBSCRIBED AND SWORN TO before me this 17th day of May, 19 63

My commission expires July 5, 1966
Bette J. Silcott
Notary Public.



15785-19066-0000

DRILLER'S LOG

RECEIVED
STATE CORPORATION COMMISSION

MAY 21 1963

Imperial Oil Company
780 Fourth National Building
Wichita, Kansas

CONSERVATION DIV.
Wichita, Kansas

ROBINSON NO. 1
C SW NW Sec. 26-16S-23W
Ness County, Kansas

Total Depth: 4532'

Commenced: 4/24/63 Completed: 5/7/63

Elevation: 2440 K.B.
Production: dry

Contractor: Imperial Oil of Kansas, Inc.
Wichita 2, Kansas

Casing Record: Set 8-5/8" surface pipe at 318' with 200 sacks cement.

Figures indicate bottom of formations:

Tops

Rock & Sand	195'	Anhydrite	1771 (+669)
Shale	318'	Heebner	3824 (-1384)
Shale & Red Bed	1030'	Toronto	3846 (-1406)
Shale & Sand	1285'	Lansing	3859 (-1419)
Dakota Sand	1500'	B/KC	4140 (-1700)
Anhydrite	1807'	Fort Scott	4244 (-1804)
Shale & Shells	2040'	Cherokee Shale	4327 (-1887)
Shale & lime	2800'	Basal Penn. Cong.	4408 (-1968)
Lime	2878'	Miss. (Osage)	4432 (-1992)
Shale & Lime	3530'	R.T.D.	4532 (-2092)
Lime	3665'		
Lime & Chalk	3835'		
Lime	4430'		
Lime & Chert	4445'		
Lime	4465'		
Lime & Chert	4532'		

We hereby certify this to be a correct and accurate log of the above described well, as shown on the daily drilling reports.

IMPERIAL OIL COMPANY

By Raymond R. Dombaugh
Raymond R. Dombaugh

Subscribed and sworn to before me this 17th day of May, 1963.

My Commission Expires:
July 5, 1966

Bette J. Silcott
Bette J. Silcott, Notary Public