


STATE OF KANSAS  
STATE CORPORATION COMMISSION  
CONSERVATION DIVISION  
P. O. BOX 17027  
WICHITA, KANSAS 67217

WELL PLUGGING RECORD

Harper County, Sec. 22 Twp. 31S Rge. (E) 8W (W)

Location as "NE/CNW/SW" or footage from lines C SE NW  
Lease Owner Petroleum, Inc.  
Lease Name Williams K Well No. 1  
Office Address 800 R. H. Garvey Bldg., 300 W. Douglas, Wichita, Ks.  
Character of Well (completed as Oil, Gas or Dry Hole) Dry Hole  
Date well completed February 21 1975  
Application for plugging filed February 20 1975  
Application for plugging approved February 20 1975  
Plugging commenced February 21 1975  
Plugging completed February 21 1975  
Reason for abandonment of well or producing formation Dry Hole

NORTH

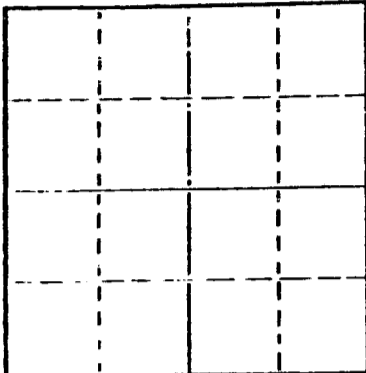

Locate well correctly on above  
Section Plat

If a producing well is abandoned, date of last production None 19  
Was permission obtained from the Conservation Division or its agents before plugging was commenced? Yes

Name of Conservation Agent who supervised plugging of this well Russell Beverstein  
Producing formation \_\_\_\_\_ Depth to top \_\_\_\_\_ Bottom \_\_\_\_\_ Total Depth of Well 4411 Feet  
Show depth and thickness of all water, oil and gas formations.

OIL, GAS OR WATER RECORDS

CASING RECORD

FORMATION	CONTENT	FROM	TO	SIZE	PUT IN	PULLED OUT
		0'	208'	8 5/8	208	None

Describe in detail the manner in which the well was plugged, indicating where the mud fluid was placed and the method or methods used in introducing it into the hole. If cement or other plugs were used, state the character of same and depth placed, from \_\_\_\_\_ feet to \_\_\_\_\_ feet for each plug set.

Plugged with 35 sacks @ 200, Mud up to 40 ft.  
10 sacks @ 40 ft. 2 sacks in rathole and 2 sacks  
in mousehole. Completed 12:00 N 2-21-75 by  
Halliburton.

(If additional description is necessary, use BACK of this sheet)

Name of Plugging Contractor DaMac Drilling Company, Inc.  
Address Box 1164, Great Bend, Kansas 67530

STATE OF Kansas COUNTY OF Barton ss.


(employee of owner) or (owner or operator) of the above-described well, being first duly sworn on oath, says: That I have knowledge of the facts, statements, and matters herein contained and the log of the above-described well as filed and that the same are true and correct. So help me God.

(Signature) Martha J. McKeown  
Box 1164, Great Bend, Kansas 67530  
(Address)

SUBSCRIBED AND SWORN TO before me this 5th day of March 1975

My commission expires November 11, 1978

Donald Sloup  
Notary Public.

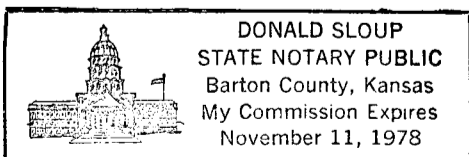

RECEIVED  
STATE CORPORATION COMMISSION

MAR 14 1975  
3-14-75  
CONSERVATION DIVISION  
Wichita, Kansas

# WELL LOG

COMPANY **Petroleum Inc.**

SEC. 22 T. 31S R. 8W

FARM **Williams K**

NO. **1**

LOC. C SE NW


TOTAL DEPTH **4411'**

COUNTY **Harper, Kansas**

COMM. **2-9-75**

COMP. **2-22-75**

CONTRACTOR **DaMac Drilling Company, Inc.**

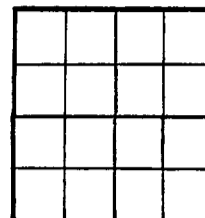

CASING **8 5/8" @ 208' w/225 SX.**

ELEVATION

PRODUCTION

FIGURES INDICATE BOTTOM OF FORMATIONS

209'	Shale and Shells
545'	Red Bed and Shale
1400'	Lime and Shale
3988'	Lime
4411'	Lime
4411'	R.T.D.

RECEIVED  
STATE CORPORATION COMMISSION  
MAR 14 1975  
3-14-75  
CONSERVATION DIVISION  
Wichita, Kansas

State of Kansas }  
County of Barton } ss

I, Rhonda Appel of DaMac Drilling Company, Inc.

upon oath state the above and foregoing is a true and correct copy of the log of the Williams K No. 1 well.

DONALD SLOUP  
STATE NOTARY PUBLIC  
Barton County, Kansas  
My Commission Expires  
November 11, 1978

Rhonda Appel

Subscribed and sworn to before me this 5th day of March 19 75

My Commission Expires: November 11, 1978

Donald Sloup  
NOTARY PUBLIC