

WELL PLUGGING RECORD

Give All Information Completely  
Make Required Affidavit  
Mail or Deliver Report to:  
Conservation Division  
State Corporation Commission  
800 Bitting Building  
Wichita, Kansas

NE/4 SE/4

Harper

County. Sec. 3 Twp. 315 Rge. 9W (E) (W)

Location as "NE/CNW/SW" or footage from lines 660 east 660 south from center of section

Lease Owner Mull Drilling Co., Inc.

Lease Name Brummer Well No. 1

Office Address 670 N. 4th Natl. Bank Bldg. Wichita, Kansas

Character of Well (completed as Oil, Gas or Dry Hole) Dry hole

Date well completed 11-18 19 58

Application for plugging filed 11/18 19 58

Application for plugging approved 11-18 19 58


Plugging commenced 10:00 A. M. 11-18 19 58

Plugging completed 11:45 A. M. 11-18 19 58

Reason for abandonment of well or producing formation Dry hole in Miss.

If a producing well is abandoned, date of last production 19

Was permission obtained from the Conservation Division or its agents before plugging was commenced? yes

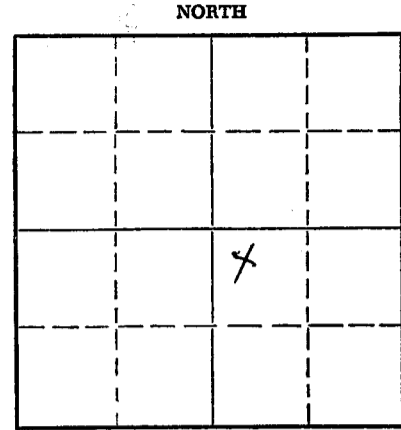

Locate well correctly on above Section Plat

Name of Conservation Agent who supervised plugging of this well Fred W. Hampel

Producing formation None Depth to top Bottom Total Depth of Well 4526 Feet

Show depth and thickness of all water, oil and gas formations.

OIL, GAS OR WATER RECORDS

CASING RECORD

FORMATION	CONTENT	FROM	TO	SIZE	PUT IN	PULLED OUT

Describe in detail the manner in which the well was plugged, indicating where the mud fluid was placed and the method or methods used in introducing it into the hole. If cement or other plugs were used, state the character of same and depth placed, from 186 feet to 40 feet for each plug set.

The hole was filled with drilling mud to depth of 186'. One plug was pushed to the depth of 186' with 1/2 sack hulls put on top 20 sacks of cement was put on top of this plug through drill pipe. Hole was then filled to within 40' of top of surface with drilling mud. #2 plug was pushed down to this depth and ten sacks of cement then put on top of plug. Rat hole plugged with 2 sacks of cement on top of sack of hulls.

(If additional description is necessary, use BACK of this sheet)

Name of Plugging Contractor none

Address

STATE OF KANSAS COUNTY OF SEDGWICK, ss.

Joseph O. Butts

(employee of owner) or (owner or operator) of the above-described

well, being first duly sworn on oath, says: That I have knowledge of the facts, statements, and matters herein contained and the log of the above-described well as filed and that the same are true and correct. So help me God.

(Signature) Joseph O. Butts

(Address)

SUBSCRIBED AND SWORN TO before me this 21st day of November, 19 58

My commission expires January 28, 1961.

Ethel Zimmerman  
Ethel Zimmerman  
Notary Public.

24-7868-S 3-53-20M

PLUGGING  
FILE SEC. 3 T. 31 R. 9W  
BOOK PAGE 146 LINE 30

NOV 25 1958  
CONSERVATION DIVISION  
Wichita, Kansas

ROTARY DRILLERS LOG

COMPANY: Mull Drilling Co., Inc.  
Wichita, Kansas

ROTARY DRILLING COMMENCED: 11-5-58

CONTRACTOR: Mull Drilling Co., Inc.  
Wichita, Kansas

ROTARY DRILLING COMPLETED: 11-18-58

CASING RECORD: Set 8 5/8" @ 234' w/150 sax  
D & A

LOCATION: Bruzner #1  
C NW/4 SE/4 3-31S-9W  
Harper County, Kansas

(Figures indicate bottom of formation - measurements from top of Rotary Bushing.)

600'	Red Bed
1300'	Red Bed & Shale
1475'	Shale & shells
1760'	Lime w/shale
2045'	Lime
3108'	Lime & Shale
3240'	Sandy Lime & Shale
3443'	Lime & Shale
3775'	Sandy Lime & Shale
3872'	Lime & Shale
4297'	Lime
4435'	Lime & Shale
4526'	Mississippi - Total Depth

I hereby certify that this is a true and correct copy of the above log to the best of my knowledge.

MULL DRILLING COMPANY, INC.

W. A. Mull, Jr.

**RECEIVED**  
STATE CORPORATION COMMISSION


DEC 12 1958

CONSERVATION DIVISION  
Wichita, Kansas

STATE OF KANSAS )  
                          ) SS  
COUNTY OF SEDGWICK)

Subscribed and sworn to before me this 24th day of November, 1958.

*Madge N. Miller*  
Madge N. Miller, Notary Public

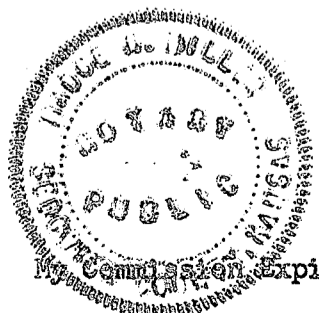

**PLUGGING**  
FILE SEC 3 T.31 R.9W  
BOOK PAGE 148 LINE 36