

Give All Information Completely
Make Required Affidavit
Mail or Deliver Report to:
Conservation Division
State Corporation Commission
211 No. Broadway
Wichita, Kansas

WELL PLUGGING RECORD

Wichita County, Sec. 34 Twp. 20S Rge. (E) 35 (W)

Location as "NE/CNW%SW%" or footage from lines 660 from west line- 1980 f/s line

Lease Owner Amarillo Oil Company

Lease Name Weesner Well No. 1

Office Address Amarillo, Texas

Character of Well (completed as Oil, Gas or Dry Hole) Oil well

Date well completed _____ 19 _____

Application for plugging filed 5 - 4 19 66

Application for plugging approved 5 - 6 19 66

Plugging commenced 5 - 7 19 66

Plugging completed 5 - 9 19 66

Reason for abandonment of well or producing formation Non Commercial

If a producing well is abandoned, date of last production April 30 19 66

Was permission obtained from the Conservation Division or its agents before plugging was commenced? Yes

Name of Conservation Agent who supervised plugging of this well W. L. Nichols

Producing formation Marmaton Depth to top 4523 Bottom 4566 Total Depth of Well 5075 Feet

Show depth and thickness of all water, oil and gas formations.

OIL, GAS OR WATER RECORDS

CASING RECORD

FORMATION	CONTENT	FROM	TO	SIZE	PUT IN	PULLED OUT
Marmaton	Oil	4523	4566	8 5/8	478	0
	Salt Water	4290	4350	4 1/2	4732	3224
Lansing K C	Dry	4012				

Describe in detail the manner in which the well was plugged, indicating where the mud fluid was placed and the method or methods used in introducing it into the hole. If cement or other plugs were used, state the character of same and depth placed, from _____ feet to _____ feet for each plug set.

Mix 15 sacks cement to plug off perforations at 4523 feet. stop plug at 4281 feet. Shoot pipe loose at 3224 feet and pull same to 650 feet. circulate mud at 650 feet and lay down two joints and pump 35 sacks cement at 600 feet to 450 feet. lay down pipe and put bridge at 35 feet and 10 sacks cement at 30 feet to 0 feet. Cut 8 5/8 inch casing off 3 feet below ground level and weld cap on same.

RECEIVED
STATE CORPORATION COMMISSION

MAY 16 1966
5-16-66
CONSERVATION DIVISION
Wichita, Kansas

(If additional description is necessary, use BACK of this sheet)

Name of Plugging Contractor Sargent's Casing Pulling Service

Address Box 506 Liberal, Kansas

STATE OF Texas, COUNTY OF Potter, ss. J. A. Tipton

(employee of owner) or (owner or operator) of the above-described well, being first duly sworn on oath, says: That I have knowledge of the facts, statements, and matters herein contained and the log of the above-described well as filed and that the same are true and correct. So help me God.


(Signature) J. A. Tipton J. A. Tipton

P. O. Box 151, Amarillo, Texas 79105
(Address)

SUBSCRIBED AND SWORN TO before me this 13th day of May, 19 66

Carolyn Blessen Carolyn Blessen
Notary Public.

My commission expires June 1, 1967

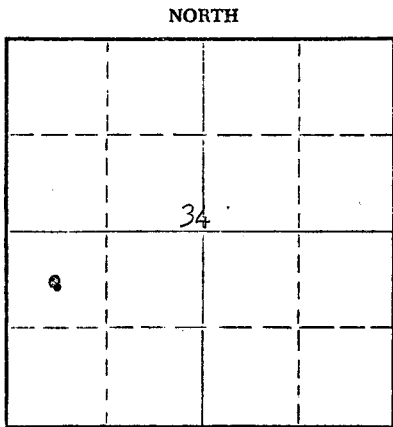

Locate well correctly on above Section Plat

WELL LOG

15-203-00020-0000

COMPANY **AMARILLO OIL COMPANY**

SEC. 34 T. 20S R. 35W

FARM **G. WEESNER** NO. 1

LOC. C-NW, SW


TOTAL DEPTH **5077'**

COUNTY **WICHITA CO., KANSAS**

COMM. **May 12, 1962**

COMP. **June 3, 1962**

CONTRACTOR **GARVEY DRILLING COMPANY**

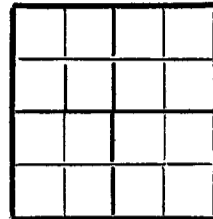

CASING **8-5/8" @ 478' w/350 sax.**
4 1/2" @ 4732' w/155 sax.

ELEVATION

PRODUCTION

FIGURES INDICATE BOTTOM OF FORMATIONS

345	Surface clay, sand & shale
470	Blue shale
885	Shale & shells
930	Sand
1150	Shale
1210	Red bed & shale;
1358	Shale & shells
1400	Anhydrite
2490	Shale & shells
2875	Shale & lime
3100	Lime & shale
3259	Shale & lime
3563	Lime
4000	Chalky lime
4090	Lime
4200	Lime & chert
4496	Lime
4644	Lime & shale
4680	Lime
4848	Lime & shale
4866	Lime & chert
4910	Lime, shale & chert
4947	Lime & shale
5077	Lime
5077	T. D.

RECEIVED
STATE CORPORATION COMMISSION

MAY 16 1966

CONSERVATION DIVISION
Wichita, Kansas

State of KANSAS }
County of BARTON } SS

I, VERNE A. MORRIS of GARVEY DRILLING COMPANY

upon oath state the above and foregoing is a true and correct copy of the log of the #1 G. WEESNER well.

Verne A. Morris

Subscribed and sworn to before me this 19th day of June 1962

My Commission Expires: November 12, 1962

Ernest A. ...
NOTARY PUBLIC