


STATE OF KANSAS  
OIL AND GAS CORPORATION COMMISSION

WELL PLUGGING RECORD

See All Information Completely  
Required Affidavit  
or Deliver Report to  
Conservation Division  
State Corporation Comm.  
245 North Water  
Wichita, KS 67202

Harper County, Sec. 22 Twp. 31S Rge. 8W E/W  
Location as "NE/CNW/SW" or footage from lines  
S $\frac{1}{2}$  - SE - NE

Lease Owner McCoy Petroleum  
Lease Name Williams Well No. C-1  
Office Address 816 Vickers, KSB&T Building, Wichita, Kansas 67202  
Character of Well (Completed as Oil, Gas or Dry Hole) \_\_\_\_\_

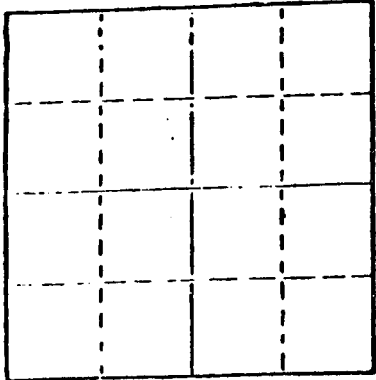

Oil  
Date Well completed \_\_\_\_\_ 19\_\_\_\_  
Application for plugging filed 12-18 1979  
Application for plugging approved 12-24 1979  
Plugging commenced 1-11 1980  
Plugging completed 1-16 1980  
Reason for abandonment of well or producing formation \_\_\_\_\_

If a producing well is abandoned, date of last production \_\_\_\_\_ 19\_\_\_\_

Was permission obtained from the Conservation Division or its agents before plugging was commenced? Yes

Name of Conservation Agent who supervised plugging of this well Bill Owens  
Producing formation \_\_\_\_\_ Depth to top \_\_\_\_\_ Bottom \_\_\_\_\_ Total Depth of Well 4382  
Give depth and thickness of all water, oil and gas formations.

OIL, GAS OR WATER RECORDS

CASING RECORD

FORMATION	CONTENT	FROM	TO	SIZE	PUT IN	PULLED OUT
				8 5/8	256	None
				4 1/2	4371	

Describe in detail the manner in which the well was plugged, indicating where the mud fluid was placed and the method or methods used in introducing it into the hold. If cement or other plugs were used, state the character of same and depth placed, from \_\_\_\_\_ feet to \_\_\_\_\_ feet for each plug set.

Sand from 4382 to 4350  
4 sacks cement 4350 to 4330

1-29-80

(If additional description is necessary, use BACK of this sheet)

Name of Plugging Contractor Clarke Corporation

STATE OF Kansas COUNTY OF Barber, ss.  
Elmer R. Margueter (employee of owner) or (owner or operator)  
the above-described well, being first duly sworn on oath, says: That I have knowledge of the facts, statements, and matters herein contained and the log of the above-described well filed and that the same are true and correct. So help me God.

(Signature) Elmer R. Margueter  
Medicine Lodge, Kansas  
(Address)

SUBSCRIBED AND SWORN TO before me this 22nd day of January, 1980

My commission expires April 4, 1982  
Jessie Hamilton  
Notary Public.