


STATE OF KANSAS  
STATE CORPORATION COMMISSION

Give All Information Completely  
Make Required Affidavit  
Mail or Deliver Report to:  
Conservation Division  
State Corporation Commission  
212 No. Market  
Wichita, Kansas

WELL PLUGGING RECORD

Ness County, Sec. 35 Twp. 16S Rge. 23W (E)\_\_\_\_(W)  
Location as "NE/CNWxSWx" or footage from lines C SE NW  
Lease Owner Halliburton Oil Producing Co.  
Lease Name Sidebottom Well No. 1  
Office Address 520 Cameron Bldg., Oklahoma City, Okla. 73106  
Character of Well (completed as Oil, Gas or Dry Hole) Dry Hole  
Date well completed May 4 19 69  
Application for plugging filed May 4 19 69  
Application for plugging approved May 4 19 69  
Plugging commenced May 4 19 69  
Plugging completed May 4 19 69  
Reason for abandonment of well or producing formation Dry Hole

NORTH

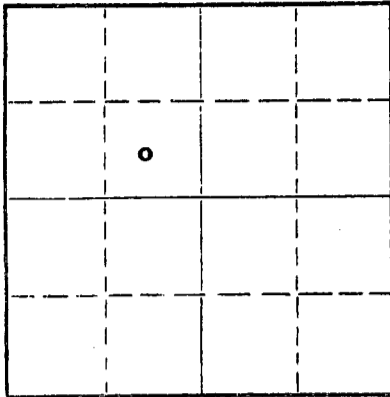

Locate well correctly on above  
Section Plat

If a producing well is abandoned, date of last production \_\_\_\_\_ 19\_\_\_\_  
Was permission obtained from the Conservation Division or its agents before plugging was com-  
menced? Yes

Name of Conservation Agent who supervised plugging of this well Eldon Petty, Hays, Kansas  
Producing formation \_\_\_\_\_ Depth to top \_\_\_\_\_ Bottom \_\_\_\_\_ Total Depth of Well 4517 Feet  
Show depth and thickness of all water, oil and gas formations.

OIL, GAS OR WATER RECORDS

CASING RECORD

FORMATION	CONTENT	FROM	TO	SIZE	PUT IN	PULLED OUT
		0	254'	8 5/8"	254'	None

Describe in detail the manner in which the well was plugged, indicating where the mud fluid was placed and the method or methods used in introducing it into the hole. If cement or other plugs were used, state the character of same and depth placed, from \_\_\_\_\_ feet to \_\_\_\_\_ feet for each plug set.

Plug: 70 sacks cement @ 800' thru D.P.  
20 sacks cement @ 240' thru D.P.  
10 sacks cement @ 40' on Bridge

RECEIVED  
STATE CORPORATION COMMISSION  
MAY 16 1969  
CONSERVATION DIVISION  
Wichita, Kansas  
5-16-69


(If additional description is necessary, use BACK of this sheet)

Name of Plugging Contractor Hellar Drilling Company, Inc.  
Address 339 Union Center Bldg., Wichita, Kansas 67202

STATE OF Kansas, COUNTY OF Sedgwick, ss.  
D. L. Hellar, Pres. of Hellar Drilling Com/pany, Inc.  
(employee of owner) or (owner or operator) of the above-described well, being first duly sworn on oath, says: That I have knowledge of the facts, statements, and matters herein contained and the log of the above-described well as filed and that the same are true and correct. So help me God.

(Signature) D. L. Hellar D. L. Hellar, President  
339 Union Center Bldg., Wichita, Kansas 67202  
(Address)

SUBSCRIBED AND SWORN to before me this 15th day of May, 19 69  
Catherine Darcey  
Catherine Darcey - Notary Public.  
March 25, 1972  
My commission expires \_\_\_\_\_

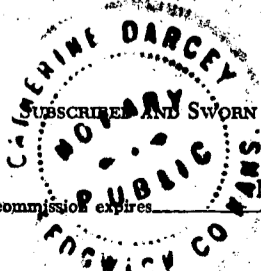

15-135-20247-0000

DRILLER'S LOG

COMPANY: Halliburton Oil Producing Co., Oklahoma City, Okla.  
 CONTRACTOR: H Hellar Drilling Company, Inc., Wichita, Kansas  
 LEASE: #1 Sidebottom  
 LOCATION: C SE NW 35-16S-23W, Ness County, Kansas  
 COMMENCED: April 25, 1969  
 COMPLETED: May 4, 1969  
 CASING: Set 8 5/8" Surface Casing @ 254'/165 sacks cement

0-43	Post Rock & Shale
43-265	Sand & shale
265-1740	Shale
1740-1775	Shale & Red Bed
1775-1815	Anhydrite
1815-2035	Shale & Red Bed
2035-2490	Shale
2490-2715	Ft. Riley Cherty Lime
2715-4446	Lime & Shale
4446-4457	#1 Core (Conglomerate)
4457-4495	Lime & dolomite
4495-4517	Dolomite & chert
4517-	Rotary Total Depth

D & A

RECEIVED  
 STATE CORPORATION COMMISSION  
 MAY 16 1969  
 CONSERVATION DIVISION  
 Wichita, Kansas

STATE OF KANSAS) )  
 ) ) SS  
 COUNTY OF SEDGWICK ) )

I, D. L. Hellar, do hereby certify that the above and foregoing is a true and correct copy of the log of the #1 Sidebottom, located in C SE NW 35-16S-23W, Ness County, Kansas, as reflected by the files of the Hellar Drilling Company, Inc.

HELLAR DRILLING COMPANY, INC.

By *D. L. Hellar*  
 President - D. L. Hellar

Subscribed and sworn to before me, a Notary Public, in and for Sedgwick County, Kansas, this 15th day of May, 1969.

*Catherine Darcey*  
 Notary Public - Catherine Darcey



March 25, 1972