

STATE OF KANSAS
STATE CORPORATION COMMISSION


15-135-21572-0000

WELL PLUGGING RECORD

Give All Information Completely
Make Required Affidavit
Mail or Deliver Report to
Conservation Division
State Corporation Comm.
245 North Water
Wichita, KS 67202

Ness County, Sec. 31 Twp. 16S Rge. 23W E/W
Location as "NE/CNW/SW" or footage from lines
C SW NE

Lease Owner Liberty Enterprises, Inc.
Lease Name Schoeffel Well No. #1
Office Address 308 West Mill Plainville, Kansas 67663
Character of Well (Completed as Oil, Gas or Dry Hole)
Dry Hole

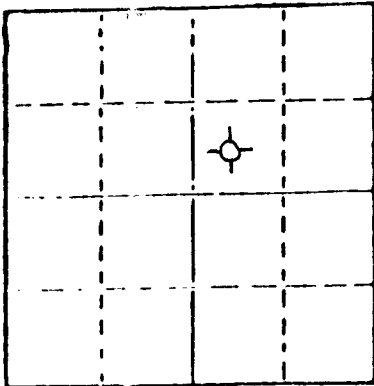

Date Well completed January 18, 1979
Application for plugging filed January 18, 1979
Application for plugging approved January 18, 1979
Plugging commenced January 18, 4:30 P.M. 1979
Plugging completed January 18, 5:00 P.M. 1979
Reason for abandonment of well or producing formation
no commercial production
If a producing well is abandoned, date of last production 19

Was permission obtained from the Conservation Division or its agents before plugging was commenced? yes

Name of Conservation Agent who supervised plugging of this well Leo F. Massey
Producing formation Depth to top Bottom Total Depth of Well
Show depth and thickness of all water, oil and gas formations.

OIL, GAS OR WATER RECORDS

CASING RECORD

FORMATION	CONTENT	FROM	TO	SIZE	PUT IN	PULLED OUT
surface casing	common	0	302.45	8 5/8"	302.45	0

Describe in detail the manner in which the well was plugged, indicating where the mud fluid was placed and the method or methods used in introducing it into the hold. If cement or other plugs were used, state the character of same and depth placed, from feet to feet for each plug set.

Plug #1 @ 660' with 70 sxs
Plug #2 @ 240' with 20 sxs
Plug #3 @ 40' with solid bridge and 10 sxs
50-50 poz 6% gel

RECEIVED
STATE CORPORATION COMMISSION
JAN 26 1979
1-26-79
CONSERVATION DIVISION
Wichita, Kansas

(If additional description is necessary, use BACK of this sheet)

Name of Plugging Contractor Pioneer Drilling Company, Inc.
308 West Mill Plainville, Kansas 67663

STATE OF Kansas COUNTY OF Rooks, ss.
Charles G. Comeau (employee of owner) or (owner or operator)

of the above-described well, being first duly sworn on oath, says: That I have knowledge of the facts, statements, and matters herein contained and the log of the above-described well as filed and that the same are true and correct. So help me God.

(Signature) Charles Comeau
308 West Mill Plainville, Kansas 67663
(Address)

SUBSCRIBED AND SWORN TO before me this 25th day of January, 1979

NOTARY PUBLIC
KRISTAL SCHWENN
Rooks County, Kansas
My Appt. Exp. 9-6-81

Krystal Schwenn
Notary Public.

My commission expires

W E L L L O G

OPERATOR: Liberty Enterprises, Inc.

WELL NAME: Schoeffel #1 LOCATION: C SW NE

COUNTY: Ness STATE: Kansas

WELL COMMENCED: January 5, 1979 WELL COMPLETED: January 18, 1979

ELEVATION: 2470' KB TOTAL DEPTH: 4528'

PRODUCTION: D & A RIG NO: #1

CASING - 8-5/8": 302.45 of 28# cemented with 150 sxs common 2% gel 3% cc

5-1/2": none

ALL MEASUREMENTS TAKEN FROM THE TOP OF ROTARY BUSHING:

FROM	TO	FORMATION	DEVIATION FROM VERTICAL	REMARKS:
0'	190'	sand and shale		
190'	310'	sand and shale		
310'	400'	sand and shale		
400'	1169'	sand and shale		
1169'	1220'	shale and sand		
1220'	1701'	sand and shale		
1701'	2005'	shale and lime		
1812'	1850'	Anhydrite		
2005'	2375'	lime and shales		
2375'	2535'	shale and lime	2492' - 7/8 degree	
2535'	2715'	lime and shale		
2715'	2865'	lime and shale		
2865'	3038'	lime and shale		
3038'	3215'	lime and shale		
3215'	3355'	lime and shale		
3355'	3518'	lime and shale	4405' 4434'	lime
3518'	3695'	lime and shale	4434' 4434'	lime 4434' - 1/2 degree
3695'	3875'	lime and shale	4434' 4480'	lime
3875'	4050'	lime and shale	4480' 4518'	lime
4050'	4145'	lime	4518' 4528'	lime
4145'	4175'	lime	4528'	RTD
4175'	4184'	lime		
4184'	4242'	lime		
4242'	4251'	lime		
4251'	4283'	lime		
4283'	4329'	lime		
4329'	4371'	lime		
4371'	4405'	lime		

RECEIVED
STATE CORPORATION COMMISSION
JAN 26 1979
CONSERVATION DIVISION
Wichita, Kansas

STATE OF KANSAS
COUNTY OF

The undersigned hereby certifies that to the best of his knowledge and belief, the above facts are true and correct

PIONEER DRILLING CO., INC.
By [Signature]

SUBSCRIBED AND SWORN TO, BEFORE ME, This 25 day of Jan., 1979.

MY COMM. EXP. SEPT. 6, 1981.

[Signature]
KRYSTAL SCHWENN - NOTARY PUBLIC

