


Give All Information Completely  
Make Required Affidavit  
Mail or Deliver Report to:  
Conservation Division  
State Corporation Commission  
211 No. Broadway  
Wichita, Kansas

WELL PLUGGING RECORD

NORTH

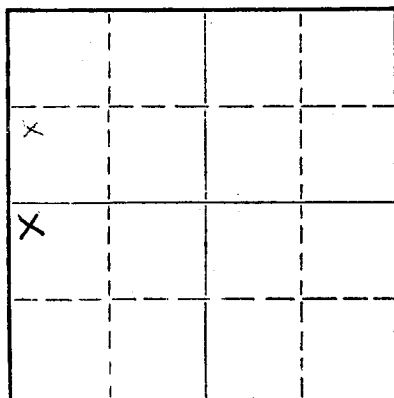

Locate well correctly on above  
Section Plat

Harper County. Sec. 3 Twp. 31 Rge. 8 (E) W (W)  
Location as "NE/CNW/SW" or footage from lines NW NW NE SW KCC  
Lease Owner Mull Drilling Co. Inc.  
Lease Name L. D. Banta Well No. E-1  
Office Address 670 N. 4th. Natl. Bank Bldg. Wichita, Kansas  
Character of Well (completed as Oil, Gas or Dry Hole) Dry Hole.  
Date well completed 11-10 1960  
Application for plugging filed 11-10 1960  
Application for plugging approved 11-10 1960  
Plugging commenced 6:30 P. M. 11-10 1960  
Plugging completed 7:30 P. M. 11-10 1960  
Reason for abandonment of well or producing formation No production  
If a producing well is abandoned, date of last production None 19    
Was permission obtained from the Conservation Division or its agents before plugging was commenced? Yes

Name of Conservation Agent who supervised plugging of this well Fred Hampel  
Producing formation \_\_\_\_\_ Depth to top \_\_\_\_\_ Bottom \_\_\_\_\_ Total Depth of Well 4490 Feet  
Show depth and thickness of all water, oil and gas formations.

OIL, GAS OR WATER RECORDS

CASING RECORD

FORMATION	CONTENT	FROM	TO	SIZE	PUT IN	PULLED OUT

Describe in detail the manner in which the well was plugged, indicating where the mud fluid was placed and the method or methods used in introducing it into the hole. If cement or other plugs were used, state the character of same and depth placed, from \_\_\_\_\_ feet to \_\_\_\_\_ feet for each plug set.

Hole filled with drilling mud to within 180' of top of surface. Plug pushed to this depth, with 1/2 sack hulls put on top of plug. 15 sacks cement mixed and put on top of hulls. Hole then filled within 30' of surface and a plug put at this depth. 1/2 sack of hulls put on top of plug and 8 sacks cement put on top of hulls filling hole to top of surface pipe. Two sacks hulls put in rat hole bridgeing same. 2 sacks cement put on top of hulls, this completed plugging.

RECEIVED  
STATE CORPORATION COMMISSION

NOV 16 1960 11-16-60

(If additional description is necessary, use BACK of this sheet)

Name of Plugging Contractor Co. Tools.  
Address Same as above.

STATE OF KANSAS, COUNTY OF SEDGWICK, ss.  
Joseph O. Butts (employee of owner) or (owner or operator) of the above-described well, being first duly sworn on oath, says: That I have knowledge of the facts, statements, and matters herein contained and the log of the above-described well as filed and that the same are true and correct. So help me God.

(Signature) Joseph O. Butts  
Mull Drilling Company, Inc. - Wichita, Kansas  
(Address)

SUBSCRIBED AND SWORN TO before me this 14th day of November, 19 60

My commission expires January 28, 1961

Ethel Zimmerman  
Notary Public.



ROTARY DRILLERS LOG

COMPANY: Mull Drilling Co., Inc.  
Wichita, Kansas

ROTARY DRILLING COMMENCED: 10-29-60

CONTRACTOR: Mull Drilling Co., Inc.  
Wichita, Kansas

ROTARY DRILLING COMPLETED: 11-10-60

CASING RECORD: Set 8 5/8" csg @ 200'  
w/135 sax cmt.  
D & A

LOCATION: BANTA "E" #1  
NW NW SW 3-31S-8W  
Harper County, Kansas

(Figures indicate bottom of formation - measurements from top of Rotary Bushing.)

670'	Red Bed	
1790'	Shale, etc.	
2950'	Shale & Lime	
3085'	Sandy Lime & Shale	
3205'	Sandy Lime	
3353'	Sandy Lime & Shale	
3526'	Lime & Shale	
3680'	Sandy Lime & Shale	
3742'	Lime w/Shale	
3798'	Lime	
4107'	Lime & Shale	
4240'	Lime	
4430'	Lime w/Shale	
4490'	Mississippi	total depth

RECEIVED  
STATE CONSERVATION COMMISSION  
NOV 16 1960  
CONSERVATION DIVISION  
Wichita, Kansas


I hereby certify that this is a true and correct copy of the above log to the best of my knowledge.

MULL DRILLING COMPANY, INC.

*R. James Gear*  
R. James Gear

STATE OF KANSAS )  
                          ) SS  
COUNTY OF SEDGWICK)

Subscribed and sworn to before me this 15th day of November, 1960

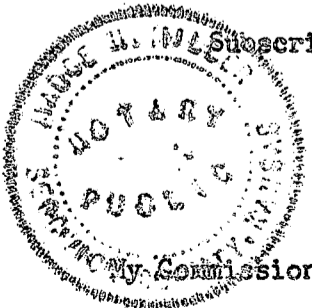

*Madge N. Miller*  
Notary Public

My Commission Expires: February 24, 1964