


STATE OF KANSAS
STATE CORPORATION COMMISSION

Give All Information Completely
Make Required Affidavit
Mail or Deliver Report to:
Conservation Division
State Corporation Commission
800 Bittling Building
Wichita, Kansas

WELL PLUGGING RECORD

NORTH

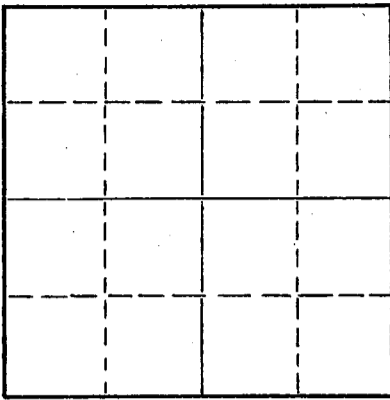

Locate well correctly on above
Section Plat

Harper County, Sec. 4 Twp. 31 Rge. 9 (E) (W)
Location as "NE/CNW/SW" or footage from lines NE NE NW
Lease Owner Petroleum, Inc.
Lease Name FREELAND 'B' Well No. 1
Office Address 311 East Third, Wichita, Kansas
Character of Well (completed as Oil, Gas or Dry Hole) Dry Hole
Date well completed April 13, 19 55
Application for plugging filed April 13, 19 55
Application for plugging approved April 13, 19 55
Plugging commenced April 13, 19 55
Plugging completed April 13, 19 55
Reason for abandonment of well or producing formation Dry Hole

If a producing well is abandoned, date of last production 19
Was permission obtained from the Conservation Division or its agents before plugging was com-
menced? Yes

Name of Conservation Agent who supervised plugging of this well Mr. M. A. Rives
Producing formation Depth to top Bottom Total Depth of Well 4505 Feet
Show depth and thickness of all water, oil and gas formations.

OIL, GAS OR WATER RECORDS

CASING RECORD

FORMATION	CONTENT	FROM	TO	SIZE	PUT IN	PULLED OUT
				8-5/8"	195'	None

Describe in detail the manner in which the well was plugged, indicating where the mud fluid was placed and the method or methods used in introducing it into the hole. If cement or other plugs were used, state the character of same and depth placed, from feet to feet for each plug set.

Mudded up to 190' and set first
good plug at 190'. Displaced
20 sacks cement on top of plug.
Mudded up to 35' and placed second
wooden plug at 35', and filled hole
to base of well cellar with 10 sacks
of cement.

RECEIVED
STATE CORPORATION COMMISSION
MAY 21 1955
5-7-1955
CONSERVATION DIVISION

(If additional description is necessary, use BACK of this sheet)
Name of Plugging Contractor Garvey Drilling Company
Address R. R. #2 - Great Bend, Kansas

STATE OF KANSAS, COUNTY OF SEDGWICK, ss.
Karl E. Becker (employee of owner) or (owner) of the above-described
well, being first duly sworn on oath, says: That I have knowledge of the facts, statements, and matters herein contained and the log of the
above-described well as filed and that the same are true and correct. So help me God.

(Signature) Karl E. Becker
311 East Third, Wichita, Kansas
(Address)

SUBSCRIBED AND SWORN TO before me this 22nd day of April, 19 55

My commission expires 8-11-58

Notary Public.

PLUGGING
PAGE 111 LINE 25

