


WELL PLUGGING RECORD

Give All Information Completely  
Make Required Affidavit  
Mail or Deliver Report to:  
Conservation Division  
State Corporation Commission  
211 No. Broadway  
Wichita, Kansas

Harper County, Sec 6 Twp. 31S Rge. 9W (E) (W)

NORTH

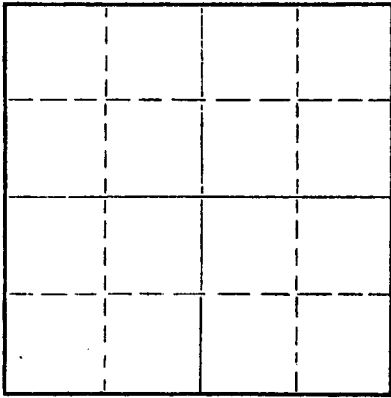

Locate well correctly on above  
Section Plat

Location as "NE/CNW/SW" or footage from lines C NW 1/4  
Lease Owner Rains & Williamson Oil Co.  
Lease Name JACOBS Well No. 1  
Office Address 1425 Wichita Plaza, Wichita, Kansas 67202  
Character of Well (completed as Oil, Gas or Dry Hole) Dry Hole  
Date well completed February 25 1966  
Application for plugging filed February 25 1966  
Application for plugging approved February 25 1966  
Plugging commenced February 25 1966  
Plugging completed February 25 1966  
Reason for abandonment of well or producing formation No oil or gas found  
in commercial quantities

If a producing well is abandoned, date of last production -- 19  
Was permission obtained from the Conservation Division or its agents before plugging was commenced? yes

Name of Conservation Agent who supervised plugging of this well Archie Elving, Pratt, Kansas  
Producing formation -- Depth to top Bottom Total Depth of Well 4480 Feet  
Show depth and thickness of all water, oil and gas formations.

OIL, GAS OR WATER RECORDS

CASING RECORD

FORMATION	CONTENT	FROM	TO	SIZE	PUT IN	PULLED OUT
				8-5/8"	228'	228'

Describe in detail the manner in which the well was plugged, indicating where the mud fluid was placed and the method or methods used in introducing it into the hole. If cement or other plugs were used, state the character of same and depth placed, from feet to feet for each plug set.

Mud back to 225' set solid bridge, cemented with 25 sx;  
Mud back to 40', set solid bridge, capped with 10 sx.  
Plug down at 8:00 P.M. 2-25-66

RECEIVED  
STATE CORPORATION COMMISSION  
MAR 4 1966

(If additional description is necessary, use BACK of this sheet)

Name of Plugging Contractor Rains & Williamson Oil Co.  
Address 1425 Wichita Plaza, Wichita, Kansas

STATE OF KANSAS, COUNTY OF SEDGWICK, ss.  
Wilson Rains

(Employee or owner) or (owner or operator) of the above-described well, being first duly sworn on oath, says: That I have knowledge of the facts, statements, and matters herein contained and the log of the above-described well as filed and that the same are true and correct. So help me God.

(Signature) Wilson Rains  
1425 Wichita Plaza, Wichita, Kansas  
(Address)

SUBSCRIBED AND SWORN TO before me this 3rd day of January, 1966

My commission expires January 8, 1968

Shirley Keck  
Notary Public.

ROTARY DRILLING LOG

Operator: Rains & Williamson Oil Co.  
#1 Jacobs  
C NW $\frac{1}{4}$  Section 6-31S-9W  
Harper County, Ks.

Contractor: Rains & Williamson  
Oil Co.  
Commenced: 2-14-66  
Completed: 2-25-66  
Remarks: Set 228' of 8-5/8" surface  
casing with 175 sz cement.

FORMATIONS

Clay & Sand	135'
Red Bed & Shale	1233'
Anhydrite	1240'
Shale & Shells	1520'
Lime & Shale	3785'
Lime	4350'
Shale	4390'
Lime	4480'
Rotary Total Depth (D & A)	4480'

RECEIVED  
STATE GOVERNMENT COMMISSION

MAR 4 1966

STATE GOVERNMENT COMMISSION  
Kansas

We certify the above log is true  
and correct to the best of our  
knowledge and belief.

RAINS & WILLIAMSON OIL CO.

*Wilson Rains*  
Wilson Rains, Partner

Subscribed and sworn to before me, a Notary Public in and for the  
State of Kansas, County of Sedgwick, this 3rd day of March, 1966.

My Commission Expires:  
January 8, 1968

*Shirley Leck*  
Shirley Leck, Notary Public