


WELL PLUGGING RECORD

Give All Information Completely
Make Required Affidavit
Mail or Deliver Report to:
Conservation Division
State Corporation Commission
800 Biting Building
Wichita, Kansas

Harper County, Sec. 12 Twp. 31S Rge. (E) 9(W)

Location as "NE/CNW/SW" or footage from lines SW NE SE
Lease Owner Beardmore Drilling Company
Lease Name Muir Well No. 2
Office Address 603 Petroleum Building, Wichita 2, Kansas
Character of Well (completed as Oil, Gas or Dry Hole) dry hole
Date well completed January 20 19 54
Application for plugging filed January 20 19 54
Application for plugging approved January 20 19 54
Plugging commenced January 20 19 54
Plugging completed January 20 19 54
Reason for abandonment of well or producing formation dry hole

NORTH

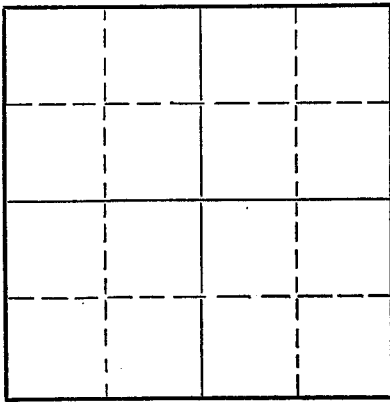

Locate well correctly on above
Section Plat

If a producing well is abandoned, date of last production 19
Was permission obtained from the Conservation Division or its agents before plugging was commenced? Yes

Name of Conservation Agent who supervised plugging of this well Ruel Durkee
Producing formation Depth to top Bottom Total Depth of Well 4500 Feet
Show depth and thickness of all water, oil and gas formations.

OIL, GAS OR WATER RECORDS

CASING RECORD

FORMATION	CONTENT	FROM	TO	SIZE	PUT IN	PULLED OUT
Red Beds & Shale		0	183	8-7/8"	183	--0--

Describe in detail the manner in which the well was plugged, indicating where the mud fluid was placed and the method or methods used in introducing it into the hole. If cement or other plugs were used, state the character of same and depth placed, from top feet to bottom feet for each plug set.

180' to 4500' - Heavy Mud
180' - Wood Plug
35' to 180' - 15 Sacks Cement
30' to 135' - Heavy Mud
30' - Wood Plug
Surface to 30' - 5 sacks Cement

(If additional description is necessary, use BACK of this sheet)

Name of Plugging Contractor Beardmore Drilling Company
Address 603 Petroleum Building, Wichita 2, Kansas

STATE OF KANSAS, COUNTY OF SEDGWICK, ss.
I, Heber Beardmore (employee of owner) or (owner or operator) of the above-described well, being first duly sworn on oath, says: That I have knowledge of the facts, statements, and matters herein contained and the log of the above-described well as filed and that the same are true and correct. So help me God.

(Signature) *Heber Beardmore*
603 Petroleum Building, Wichita 2, Kansas
(Address)

SUBSCRIBED AND SWORN TO before me this 26th day of January, 19 54

My commission expires *200-1-1957*
January 28, 1956 *Jafer English* Notary Public.

24-7366-S 3-53-20M

PLUGGING
FILE SEC 12 T 31 R 9 W
BOOK PAGE 4 LINE 19

1-29-1954

MUIR NO. 2

SW NE SE
Section 12-31S-9W
Harper County, Kansas

Drilled for: Beardmore Drilling Company
Drilled by: Beardmore Drilling Company

Casing Record:

8-5/8" 183#w/100 Sacks

Drilling Commenced: January 5, 1954
Drilling Completed: January 20, 1954

Elevation: DF 1675

<u>FORMATION</u>	<u>DEPTH</u>
Cellar	5
Red Bed - Shale	183
Shale - Shells	1605
Lime - Shale	2270
Shale - Lime	2750
Lime - Shale	2880
Shale - Lime	3105
Lime - Shale	3575
Lime - Sand	3610
Shale - Lime	3685
Lime	4015
Lime - Shale	4120
Lime	4170
Lime - Shale	4395
Lime	4500 T. D.

D & A

TOPS:

Mississippi 4425

DST #1 - 4460-4470 - Open 1 hour, shut in 15 minutes, recovered 90# mud,
BHP 260#.

STATE OF KANSAS

COUNTY OF SEDGWICK ^{ss}

I, the undersigned, being duly sworn on oath state that the above and within statement is a true and correct record and log of the well drilled on the location above-described, to the best of my knowledge and belief.

W. H. Beardmore

Subscribed and sworn to before me this 27th day of January, 1954.

Jaeger English
Notary Public

My Commission Expires:

Nov - 1 - 1957

PLUGGING
MUIR SEC 12-31S-9W
PAGE 9 LINE 19