


WELL PLUGGING RECORD

Give All Information Completely
Make Required Affidavit
Mail or Deliver Report to:
Conservation Division
State Corporation Commission
212 North Market, Insurance Bldg.
Wichita, Kansas

NORTH

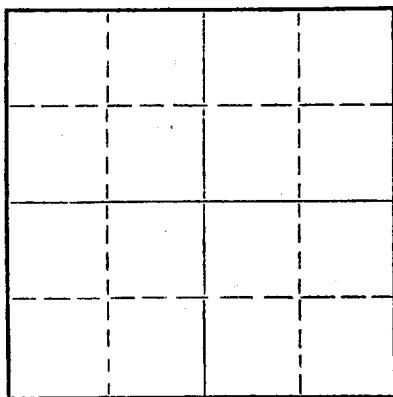

Locate well correctly on above
Section Plat

Harper County. Sec. 12 Twp. 31 S. Rge. 9 (X) W (W)
Location as "NE/CNW/SW" or footage from lines NW NW
Lease Owner Beardmore Drilling Company
Lease Name Muir "B" Well No. 1
Office Address 827 Beacon Building, Wichita, Kansas
Character of Well (completed as Oil, Gas or Dry Hole) Dry Hole
Date well completed 7-29 1959
Application for plugging filed 7-29 1959
Application for plugging approved 7-29 1959
Plugging commenced 7-29 1959
Plugging completed 7-29 1959
Reason for abandonment of well or producing formation

If a producing well is abandoned, date of last production 19
Was permission obtained from the Conservation Division or its agents before plugging was commenced? Yes

Name of Conservation Agent who supervised plugging of this well Fred Hampel
Producing formation Depth to top Bottom Total Depth of Well 4515 Feet
Show depth and thickness of all water, oil and gas formations.

OIL, GAS OR WATER RECORDS

CASING RECORD

FORMATION	CONTENT	FROM	TO	SIZE	PUT IN	PULLED OUT
Shale		0	40			
Sand		40	110			
Red Bed		110	219	8-5/8"	219'	0

Describe in detail the manner in which the well was plugged, indicating where the mud fluid was placed and the method or methods used in introducing it into the hole. If cement or other plugs were used, state the character of same and depth placed, from feet to feet for each plug set.

0 to 40' - 10 sacks cement
40' - Wood Plug
40' to 120' - Heavy Mud
120' to 210' - 18 sacks cement
210' - Wood Plug
210' to 4515' - Heavy mud

RECEIVED
STATE CORPORATION COMMISSION
AUG 7 1959
CONSERVATION DIVISION
Wichita, Kansas

Note: Also 2 sacks cement in Rat Hole at 6 ft.

(If additional description is necessary, use BACK of this sheet)

Name of Plugging Contractor Beardmore Drilling Company
Address 827 Beacon Building, Wichita 2, Kansas

STATE OF Kansas, COUNTY OF Sedgwick, ss.
Heber Beardmore (employee of owner) or (owner or operator) of the above-described well, being first duly sworn on oath, says: That I have knowledge of the facts, statements, and matters herein contained and the log of the above-described well as filed and that the same are true and correct. So help me God.

(Signature) *Heber Beardmore*
827 Beacon Building, Wichita 2, Kansas
(Address)

SUBSCRIBED AND SWORN TO before me this 5th day of August, 1959.

My commission expires April 9, 1960. *Barbara Springsteen* Barbara Springsteen Notary Public.

PLUGGING
FILE SEC 12 T. 31 R. 9 W
BOOK PAGE 58 LINE 38

BEARDMORE DRILLING COMPANY
 #1 MUIR "B"
 NW NW Section 12-31S-9W
 Harper County, Kansas

Drilled By: Beardmore Drilling Company
 Drilling Commenced: 7-18-59
 Drilling Completed: 7-29-59

Casing Record:

8-5/8" set at 219' with 150 sacks common cement, on 7-18-59.

Elevations:

1684 KB
 Est. 1681 DF
 1678 GR

RECEIVED
 COMMISSION
 AUG 7 1959
 CONSERVATION DIVISION
 Wichita, Kansas

<u>FORMATIONS</u>	<u>DEPTH</u>
Cellar	5
Shale	40
Sand	110
Red Bed	219
Shale and Shells	1440
Anhydrite	1465
Red Bed, Shale and Shells	1025
Shale and Shells	1440
Anhydrite	1475
Lime and Shale	2065
Lime	2150
Shale and Lime	3105
Lime and Shale	3215
Lime and Shale	3281
Shale and Lime	3410
Lime and Shale	3520
Shale and Lime	3599
Sand	3680
Lime and Shale	3760
Lime	4292
Lime and Shale	4355
Lime	4482
Chert and Lime	4505
DST #1	4471-4482
Chert and Lime	4515
DST #2	4485-4515
Total Depth	4515

DST #1 4471-4482. Shut in 20 min., open 1 hr., shut in 20 min., good blow, recovered 105' oil specked and gas cut mud. IBHP 585, FBHP 535, IF 15, FF 35

DST #2 4485-4515. Shut in 20 min., open 1 hr., shut in 20 min., good blow, recovered 210' oil specked and gas cut mud. IBHP 735, FBHP 535, IF 70, FF 105.

STATE OF KANSAS)
) ss:
 COUNTY OF SEDGWICK)

I, the undersigned, being duly sworn on oath, state that the above and within statement is a true and correct record and log of the well drilled on the location above described, to the best of my knowledge and belief.

BEARDMORE DRILLING COMPANY

By *[Signature]*

Subscribed and sworn to before me this 5th day of August, 1959.

[Signature]
 Barbara Springsteen, Notary Public

PLUGGING
 FILE SEC. 12T 31 R 9W
 PAGE 58 LINE 35

My commission expires: 4-9-60.