


STATE OF KANSAS
STATE CORPORATION COMMISSION
CONSERVATION DIVISION
P. O. BOX 17027
WICHITA, KANSAS 67217

WELL PLUGGING RECORD

Harper County, Sec. 12 Twp. 31S Rge. 9W (E) (W)
Location as "NE/CNW/SE" or footage from lines 150' E. of C SW SE
Lease Owner Mr. Ellis D. Bever
Lease Name Muir Well No. 1
Office Address 713 First National Bank Bldg., Wichita, Kansas 67202
Character of Well (completed as Oil, Gas or Dry Hole) D & A
Date well completed April 12 19 75
Application for plugging filed April 12 19 75
Application for plugging approved April 12 19 75
Plugging commenced April 12 19 75
Plugging completed April 12 19 75
Reason for abandonment of well or producing formation D & A

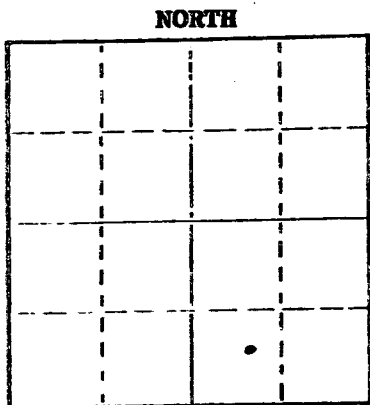

Locate well correctly on above Section Plot

If a producing well is abandoned, date of last production 19
Was permission obtained from the Conservation Division or its agents before plugging was commenced? Yes

Name of Conservation Agent who supervised plugging of this well Mr. G.R. Biberstein
Producing formation _____ Depth to top _____ Bottom _____ Total Depth of Well 4475 Feet
Show depth and thickness of all water, oil and gas formations.

OIL, GAS OR WATER RECORDS

CASING RECORD

FORMATION	CONTENT	FROM	TO	SIZE	PUT IN	PULLED OUT
				8-5/8"	241'	-0-

Describe in detail the manner in which the well was plugged, indicating where the mud fluid was placed and the method or methods used in introducing it into the hole. If cement or other plugs were used, state the character of same and depth placed, from _____ feet to _____ feet for each plug set.

Mud to 225' spotted 35 sx. cmt.
Mud to 40' 1/4 sk. hulls & plug w/15 sx. cmt.
2 sx. in rathole.

RECEIVED
STATE CORPORATION COMMISSION
05-30-75
CONSERVATION DIVISION
WICHITA, KANSAS

(If additional description is necessary, use BACK of this sheet)
Name of Plugging Contractor Red Tiger Drilling Company
Address 1720 Wichita Plaza, Wichita, Kansas 67202


STATE OF Kansas COUNTY OF Sedgwick ss.
Linda H. Dickens (employee of owner) or (owner or operator) of the above-described well, being first duly sworn on oath, says: That I have knowledge of the facts, statements, and matters herein contained and the log of the above-described well as filed and that the same are true and correct. So help me God.

(Signature) Linda H. Dickens
1720 Wichita Plaza, Wichita, Kansas 67202
(Address)

SUBSCRIBED AND SWORN TO before me this 14th day of April, 1975

My commission expires December 28, 1977

[Signature]
Notary Public.

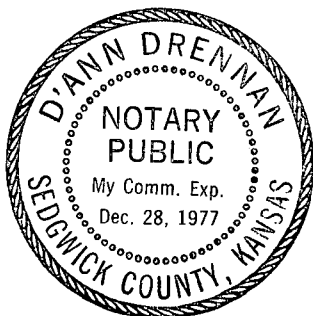

DRILLERS LOG

No. 1 Muir

CASING RECORD:

3-5/8" @ 241'
w/200 sx. cmt.

COMPANY:

Mr. Ellis D. Bever

DESCRIPTION:

150' East of
C SW SE
12-31S-9W
Harper County,
Kansas

CONTRACTOR:

Red Tiger Drilling Co.

COMMENCED:

April 3, 1975

COMPLETED:

April 12, 1975

TOTAL DEPTH: 4475'

ELEVATION: 1645' K.S.

FORMATION

FROM

TO

REMARKS

Sand	0	75
Redbed & Shale	75	1025
Shale & Shell	1025	1393
Lime	1393	1575
Lime & Shale	1575	1930
Lime w/Shale	1980	2205
Lime & Shale	2205	2910
Lime	2910	3565
Shale	3565	3569
Shale & Sand	3569	3625
Lime	3625	3905
Lime & Shale	3905	4075
Lime	4075	4230
Lime & Shale	4230	4305
Lime	4305	4417
Lime & Chert	4417	4475

I certify that this is a true and correct copy of the above log to the best of my knowledge.

RED TIGER DRILLING COMPANY

Linda H. Dickens
Linda H. Dickens

Subscribed and sworn to before me this 14th day of April, 1975.

D. Ann Duesman
Notary Public

