


WELL PLUGGING RECORD

Give All Information Completely
Make Required Affidavit
Mail or Deliver Report to:
Conservation Division
State Corporation Commission
212 No. Market
Wichita, Kansas

NORTH

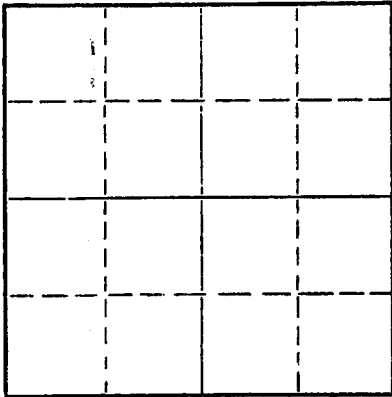

Locate well correctly on above
Section Plat

Harper County, Sec. 9 Twp. 31 Rge. 9 (E) (W) X
Location as "NE/CNWxSWx" or footage from lines SW SE NW
Lease Owner E. K. Edmiston
Lease Name Cox A Well No. #1
Office Address 425 First National Bank Bldg., Wichita, Kansas
Character of Well (completed as Oil, Gas or Dry Hole)
Date well completed 19
Application for plugging filed 19
Application for plugging approved 19
Plugging commenced 8-6-67 19
Plugging completed 8-14-67 19
Reason for abandonment of well or producing formation

If a producing well is abandoned, date of last production 19
Was permission obtained from the Conservation Division or its agents before plugging was commenced?

Name of Conservation Agent who supervised plugging of this well Archie Elving
Producing formation Depth to top Bottom Total Depth of Well 4465' Feet
Show depth and thickness of all water, oil and gas formations.

OIL, GAS OR WATER RECORDS

CASING RECORD

FORMATION	CONTENT	FROM	TO	SIZE	PUT IN	PULLED OUT
				4 1/2"	4465'	3444.42'
				8 5/8"	275'	

Describe in detail the manner in which the well was plugged, indicating where the mud fluid was placed and the method or methods used in introducing it into the hole. If cement or other plugs were used, state the character of same and depth placed, from feet to feet for each plug set.

Made bottom hole plug back with sand to 4400', mixed and ran 4 sacks cement thru dump bailer.
Mudded hole to 260', set 10' rock bridge. Mixed and ran 25 sacks cement thru dump bailer. Mudded hole to 40', set 10' rock bridge. Mixed and dumped 10 sacks cement to base of cellar.

RECEIVED
STATE CORPORATION COMMISSION
AUG 16 1967
CONSERVATION DIVISION
Wichita, Kansas

(If additional description is necessary, use BACK of this sheet)

Name of Plugging Contractor Southwest Casing Pulling Co., Inc.
Address Box 364, Great Bend, Kansas

STATE OF Kansas, COUNTY OF Barton, ss.
Southwest Casing Pulling Co., Inc. (employee of owner) or (owner or operator) of the above-described well, being first duly sworn on oath, says: That I have knowledge of the facts, statements, and matters herein contained and the log of the above-described well as filed and that the same are true and correct. So help me God.

(Signature) W. C. Spencer
Box 364, Great Bend, Kansas
(Address)

SUBSCRIBED AND SWORN TO before me this 15 day of August, 19 67

My commission expires 24 October 1968
Notary Public.

DRILLER'S LOG

Company: E. K. Edmiston
First National Bank Building
Wichita, Kansas 67202

Rotary Drilling Commenced: July 2, 1965

Rotary Drilling Completed: July 12, 1965

Well Name: COX No. 1
SW SE NW 9-31S-9W
Harper County, Kansas

Contractor: E. K. Edmiston Drilling Co., Inc.
First National Bank Building
Wichita, Kansas 67202

Casing Record: 275' of 8-5/8" with 225 sacks cement
4465' of 4-1/2" with 125 sacks cement

LOG

Measurements from top of Kelly bushing

Clay and Sand	0 - 70
Sand and Shale	275
Shale and Red Bed	630
Shale and Shells	1365
Shale	1728
Shale and Lime	2010
Lime and Shale	2125
Shale and Lime	2865
Lime	2935
Lime and Shale	3315
Lime	3448
Shale and Lime	3554
Lime	4465 RTD

RECEIVED
AUG 1 1967
CONSERVATION DIVISION
Wichita, Kansas

The undersigned, E. K. Edmiston, President of E. K. Edmiston Drilling Co., Inc., hereby certifies on behalf of said company, that the above log is a true and correct log of the formations encountered in drilling the above well, as reflected by the daily drilling reports.

E. K. EDMISTON DRILLING CO., INC.

By [Signature]
E. K. Edmiston, President

STATE OF KANSAS,
SS:
SEDGWICK COUNTY,

BE IT REMEMBERED that on this 21st day of July, 1965, before me, the undersigned, a Notary Public within and for the county and state aforesaid, came E. K. EDMISTON, known to me to be the same person who executed the foregoing instrument as President and on behalf of the E. K. Edmiston Drilling Co., Inc., and he duly acknowledged the execution of the same for himself and for said company.

IN WITNESS WHEREOF, I have hereunto set my hand and official seal on the day and year last above written.

[Signature]
A. E. Bargaen, Notary Public

