

15135-22220-0000


STATE OF KANSAS
STATE CORPORATION COMMISSION

WELL PLUGGING RECORD

Give All Information Completely
Make Required Affidavit
Mail or Deliver Report to
Conservation Division
State Corporation Comm.
245 North Water
Wichita, KS 67202

Ness County, Sec. 16 Twp. 16S Rge. 23W E/W
Location as "NE/CNW 1/4 SW 1/4" or footage from lines
E/2 W/2 SW

Lease Owner Beren Corporation
Lease Name Baer Well No. #5
Office Address 970 4th Fin. Ctr., Wichita, Kansas 67202
Character of Well (Completed as Oil, Gas or Dry Hole)

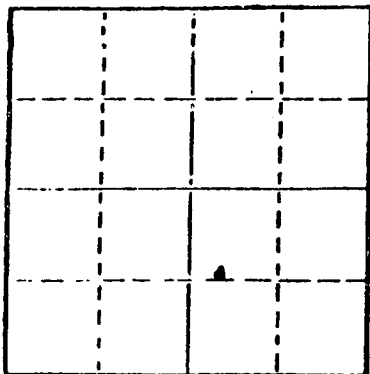

Locate well correctly on above
Section Plat

Dry Hole
Date Well completed April 30, 1982
Application for plugging filed April 30, 1982
Application for plugging approved April 30, 1982
Plugging commenced April 30, 1982
Plugging completed April 30, 1982
Reason for abandonment of well or producing formation
Dry Hole

If a producing well is abandoned, date of last production
19

Was permission obtained from the Conservation Division or
its agents before plugging was commenced? Yes

Name of Conservation Agent who supervised plugging of this well Steve Durant
Producing formation _____ Depth to top _____ Bottom _____ Total Depth of Well _____
Show depth and thickness of all water, oil and gas formations.

OIL, GAS OR WATER RECORDS

CASING RECORD

FORMATION	CONTENT	FROM	TO	SIZE	PUT IN	PULLED OUT

Describe in detail the manner in which the well was plugged, indicating where the mud fluid
was placed and the method or methods used in introducing it into the hold. If cement or other
plugs were used, state the character of same and depth placed, from _____ feet to
_____ feet for each plug set.

- 80 sks @ 1110'
- 40 sks @ 330'
- 10 sks @ 40' hulls & plug
- 10 sks Rathole
- 10 sks Mousehole
- Cement is 50-50 Pozmix 4% Gel, 3% CC

(If additional description is necessary, use BACK of this sheet)

Name of Plugging Contractor Sun Cementing

STATE OF Kansas COUNTY OF Sedgwick, ss.
J. D. Marcus (employee of owner) or (owner or operator)

of the above-described well, being first duly sworn on oath, says: That I have knowledge of
the facts, statements, and matters herein contained and the log of the above-described well
as filed and that the same are true and correct. So help me God.

(Signature) J. D. Marcus
401 E. Douglas, Suite 402, Wichita, Kansas 67202
(Address)

SUBSCRIBED AND SWORN TO before me this 30th day of April, 1982

Cheryl L. Benoit
Notary Public.

My commission expires June 8, 1985

