

STATE OF KANSAS  
STATE CORPORATION COMMISSION


15-007-00578-00-00  
WELL PLUGGING RECORD

Give All Information Completely  
Make Required Affidavit  
Mail or Deliver Report to:  
Conservation Division  
State Corporation Commission  
800 Biting Building  
Wichita, Kansas

Barber County. Sec. 28 Twp. 30S Rge. (E) 11 (W)  
Location as "NE/CNW/SW" or footage from lines SW SW SE  
Lease Owner Aylward Drilling Company et al  
Lease Name Keimig Well No. 1  
Office Address 813 1st Natl. Bank Bldg., Wichita, Kansas  
Character of Well (completed as Oil, Gas or Dry Hole) Dry Hole  
Date well completed April 22 19 54  
Application for plugging filed April 22 19 54  
Application for plugging approved April 22 19 54  
Plugging commenced April 23 19 54  
Plugging completed April 23 19 54  
Reason for abandonment of well or producing formation \_\_\_\_\_

If a producing well is abandoned, date of last production \_\_\_\_\_ 19 \_\_\_\_  
Was permission obtained from the Conservation Division or its agents before plugging was commenced? Yes

Name of Conservation Agent who supervised plugging of this well Mr. M. A. Rives  
Producing formation \_\_\_\_\_ Depth to top \_\_\_\_\_ Bottom \_\_\_\_\_ Total Depth of Well \_\_\_\_\_ Feet  
Show depth and thickness of all water, oil and gas formations.

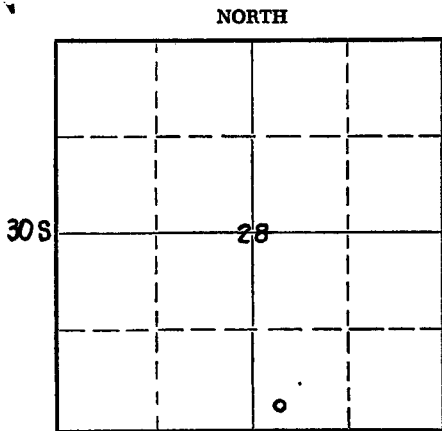

Locate well correctly on above Section Plat

OIL, GAS OR WATER RECORDS

CASING RECORD

FORMATION	CONTENT	FROM	TO	SIZE	PUT IN	PULLED OUT
				8 5/8"	285'	None

Describe in detail the manner in which the well was plugged, indicating where the mud fluid was placed and the method or methods used in introducing it into the hole. If cement or other plugs were used, state the character of same and depth placed, from \_\_\_\_\_ feet to \_\_\_\_\_ feet for each plug set.


Filled hole with heavy mud from 4870' to 270' - cement plug from 270' to 210' with 20 sacks cement - Mud 210' to 45' - top plug from 45' to bottom of cellar with 10 sacks cement.

(If additional description is necessary, use BACK of this sheet)  
Name of Plugging Contractor Aylward Drilling Company 05-01-1954  
Address 813 1st Natl. Bank Bldg., Wichita, Kansas

STATE OF Kansas, COUNTY OF Sedgwick, ss.  
Paul W. Hesse (employee of owner) ~~SEE XXXXXXXXXXX~~ of the above-described well, being first duly sworn on oath, says: That I have knowledge of the facts, statements, and matters herein contained and the log of the above-described well as filed and that the same are true and correct. So help me God.  
(Signature) Paul W. Hesse

SUBSCRIBED AND SWORN to before me this 27th day of April, 19 54

My commission expires December 11, 1957  
Duane Jessup Notary Public.

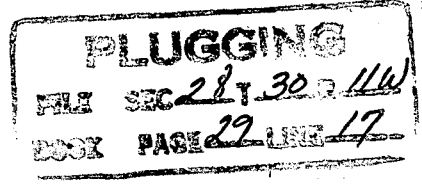

24-7368-S 3-53-20M

Casing Record: Company: Aylward Drilling Company et al Location: SW SW SE  
 8-5/8" 285' Contractor: Aylward Drilling Company Sec. 28-30-11W Barber County, Kansas  
 Commenced: April 3, 1954 Elevation: 1799 R.B.  
 Completed: April 23, 1954

	From	To	Remarks
Surface Clay	0	30	Set 285' of 8-5/8" surface casing, cement with 200 sacks
Sand	30	264	
Redbed	264	810	
Redbed & Shale	810	1060	
Shale & Lime Shells	1060	1476	
Anhydrite	1476	1500	
Shale & Sandy Lime	1500	1550	
Sand & Shale	1550	1770	
Anhydrite	1770	1785	
Lime	1785	1795	
Shale & Sandy Lime	1795	1989	
Lime & Shale	1989	2103	
Lime	2103	2265	
Lime & Shale	2265	2790	
Lime	2790	2815	
Shale & Lime	2815	3110	
Lime	3110	3195	
Chalky Lime	3195	3215	
Sandy Lime	3215	3293	
Shale & Lime	3293	3580	
Sand - Elgin	3580	3590	
Sand	3590	3595	
Sand & Shale	3595	3670	
Lime & Shale	3670	3775	
Sand	3775	3795	
Sand & Shale	3795	3878	
Lime (K.C.)	3878	3920	
Lime	3920	4280	
Lime & Shale	4280	4310	
Sandy-Lime & Shale	4310	4370	
Lime & Shale	4370	4406	
Chat Miss.	4406	4417	
Shale & Chat	4417	4430	
Chat - Chert	4430	4453	
Lime	4453	4480	
Shale & Lime	4480	4685	
Lime	4685	4740	
Sandy Shale	4740	4760	
Lime	4760	4773	
Sand	4773	4778	
Shale	4778	4800	
Shale & Lime	4800	4870 T.D.	

TOPS:

Elgin Sand	3580
Douglas Sand	3788
Brown Lime	3871
Lansing Kansas City	3885
Mississippi	4410
Kinderhook	4461
Chattanooga	4627
Viola	4659
Simpson Shale	4741
Simpson Dol. Sand	4743
Simpson Sand	4768
Arbuckle	4843

RECEIVED  
 STATE CORPORATION COMMISSION  
 CONSERVATION DIVISION  
 Wichita, Kansas

05-01-1954

- D.S.T. #1 - 3560-95 - Open 60" - Recovered 20' Mud - B.H.P. 1100#.
- D.S.T. #2 - 3751-95 - Open 15" - Recovered 2600' Salt Water - B.H.P. 1380#.
- D.S.T. #3 - 4258-80 - Open 45" - Recovered 45' slightly oil specked mud - B.H.P. 1450#.
- D.S.T. #4 - 4400-17 - Open 45" - Recovered 25' mud - B.H.P. 45#.
- D.S.T. #5 - 4400-30 - Open 45" - Recovered 5' mud - B.H.P. 25#.
- D.S.T. #6 - 4735-60 - Open 35" - Recovered 7' mud - B.H.P. 60#.
- D.S.T. #7 - 4841-70 - Open 1 Hr. - Recovered 184' muddy salt water - B.H.P. 1210#.

I certify that this is a true and correct copy of the above log to the best of my knowledge.

*Paul W. Hesse*  
 Paul W. Hesse

Subscribed and sworn to before me this 29th day of April 1954.

*Duane Jessup*  
 Notary Public

My Commission expires: December 11, 1957.

