


15-007-20214-00-00

STATE OF KANSAS  
STATE CORPORATION COMMISSION

Form CP-4

Give All Information Completely  
Make Required Affidavit  
Mail or Deliver Report to:  
Conservation Division  
State Corporation Commission  
P. O. Box 17027  
Wichita, Kansas 67217  
NORTH

WELL PLUGGING RECORD

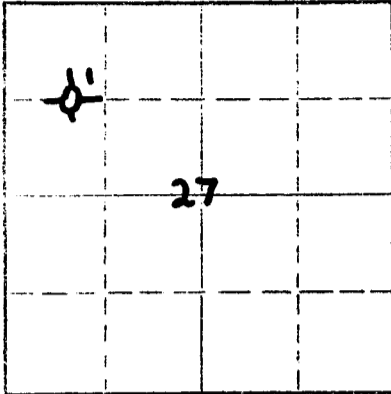

Locate well correctly on above  
Section Plat

Barber County, Sec. 27 Twp. 30S Rge. (E) 11W(W)  
Location as "NE/CNW/SW" or footage from lines C. E/2 W/2 NW/4  
Lease Owner Hoover & Bracken Oil Properties, Inc.  
Lease Name Bell Well No. 1  
Office Address 3232 Liberty Tower, Oklahoma City, Oklahoma 73102  
Character of Well (completed as Oil, Gas or Dry Hole) Dry Hole  
Date well completed 12-14-72 19  
Application for plugging filed 12-14-72 19  
Application for plugging approved 12-14-72 19  
Plugging commenced 12-14-72 19  
Plugging completed 12-14-72 19  
Reason for abandonment of well or producing formation dry hole

If a producing well is abandoned, date of last production 19  
Was permission obtained from the Conservation Division or its agents before plugging was commenced? yes

Name of Conservation Agent who supervised plugging of this well G. R. Biberstein, Attica, Kansas  
Producing formation NONE Depth to top Bottom Total Depth of Well 4000 Feet  
Show depth and thickness of all water, oil and gas formations.

OIL, GAS OR WATER RECORDS

CASING RECORD

FORMATION	CONTENT	FROM	TO	SIZE	PUT IN	PULLED OUT
				8-5/8"	261'	NONE

Describe in detail the manner in which the well was plugged, indicating where the mud fluid was placed and the method or methods used in introducing it into the hole. If cement or other plugs were used, state the character of same and depth placed, from feet to feet for each plug set.

Plugged at 250' w/35 sacks  
40' w/15 sacks

RECEIVED  
STATE CORPORATION COMMISSION  
JAN 19 1973  
CONSERVATION DIVISION  
Wichita, Kansas  
01-19-1973

(If additional description is necessary, use BACK of this sheet)

Name of Plugging Contractor Thomas Drilling Co.  
Address P. O. Box 400, Duncan, Oklahoma 73533

STATE OF Oklahoma COUNTY OF Stephens, SS.  
T. H. McCasland, Jr. (employee of owner) or (owner or operator) of the above-described well, being first duly sworn on oath, says: That I have knowledge of the facts, statements, and matters herein contained and the log of the above-described well as filed and that the same are true and correct. So help me God.

(Signature) Thomas McCasland, Jr.  
Thomas Drilling Co., President  
P. O. Box 400, Duncan, Oklahoma 73533  
(Address)

SUBSCRIBED AND SWORN TO before me this 5th day of January, 19 73

My commission expires 3-24-75

Josephine Bentley  
Notary Public.

15-007-20214-00-00

HOOVER AND BRACKEN  
3232 Liberty Tower  
Oklahoma City, Oklahoma 73102

Oil Properties, Inc

Handwritten notes: "15-007-20214-00-00", "STC C & O", "CLP"

DRILLERS WELL LOG

#1 Bell

C E/2 W/2 NW/4 - Section 27-30S-11W  
Barber County, Kansas  
Elevation: 1794 GL; 1801 KB  
Initial Production: None  
Contractor: Thomas Drilling Co.

Commenced R.D. 12-7-72  
Completed R.D. 12-14-72  
Rotary Total Depth 4000'

STRATA	DEPTH
Shale	0 - 327
Red Bed, Shale	327 - 1075
Shale, Shells	1075 - 1244
Shale, Anhydrite	1244 - 1755
Shale, Lime	1755 - 1996
Lime	1996 - 2385
Lime, Shale	2385 - 2500
Lime	2500 - 2744
Lime, Shale	2744 - 3800
Lime	3800 - 4000

RECEIVED  
STATE CORPORATION COMMISSION  
APR 16 1973  
CONSERVATION DIVISION  
Wichita, Kansas  
04-16-1973  
RTD

I hereby certify that the above is a true and correct log of said well as reflected by the daily drilling reports.

THOMAS DRILLING COMPANY

By T. H. McCasland, Jr.  
T. H. McCasland, Jr.  
President

Signed and sworn to in my presence this  
5th day of January, 1973, by T. H. McCasland, Jr.  
acting agent of Hoover and Bracken.....

Josephine Bentley  
Notary Public, Josephine Bentley

My commission expires:

3-24-75

Originally filed 2-27-73