


STATE OF KANSAS  
STATE CORPORATION COMMISSION

WELL PLUGGING RECORD

Give All Information Completely  
Make Required Affidavit  
Mail or Deliver Report to  
Conservation Division  
State Corporation Comm.  
245 North Water  
Wichita, KS 67202

HARPER County. Sec. 19 Twp. 32 Rge. 8 E/W  
Location as "NE/CNW $\frac{1}{4}$ /SW $\frac{1}{4}$ " or footage from lines \_\_\_\_\_

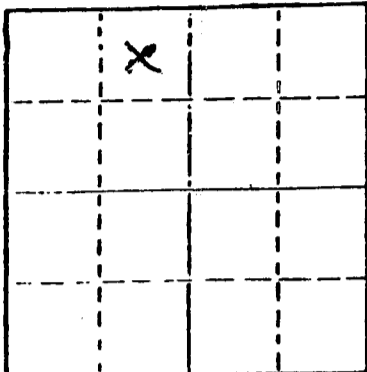

Lease Owner RESOURCE VENTURES CORP  
Lease Name JAMES J & NYLA J. FERRELL Well No. #1  
Office Address 1501 SUPERIOR LINCOLN, NEBR 68521  
Character of Well (Completed as Oil, Gas or Dry Hole) \_\_\_\_\_

DRY HOLE  
Date Well completed \_\_\_\_\_ 19\_\_\_\_  
Application for plugging filed 9/12 1981  
Application for plugging approved 9/12 1981  
Plugging commenced 9/12 1981  
Plugging completed 9/12 1981

Reason for abandonment of well or producing formation \_\_\_\_\_  
FORMATION WET  
If a producing well is abandoned, date of last production \_\_\_\_\_ 19\_\_\_\_

Was permission obtained from the Conservation Division or its agents before plugging was commenced? yes

Name of Conservation Agent who supervised plugging of this well MAURICE LESLEY  
Producing formation \_\_\_\_\_ Depth to top \_\_\_\_\_ Bottom \_\_\_\_\_ Total Depth of Well \_\_\_\_\_  
Show depth and thickness of all water, oil and gas formations.

OIL, GAS OR WATER RECORDS

CASING RECORD

| FORMATION | CONTENT | FROM | TO | SIZE | PUT IN | PULLED OUT |
|-----------|---------|------|----|------|--------|------------|
|           |         |      |    |      |        |            |
|           |         |      |    |      |        |            |
Describe in detail the manner in which the well was plugged, indicating where the mud fluid was placed and the method or methods used in introducing it into the hold. If cement or other plugs were used, state the character of same and depth placed, from \_\_\_\_\_ feet to \_\_\_\_\_ feet for each plug set.

60 SACKS @ 620' - 40 SACKS @ 270' - 10 SACKS @ 40' - 10 SACKS IN RAYBOLD  
50/50 PD2 MIX - 4% GEL - 3% CALCIUM CHLORIDE

3 PLUGS SET - TOP PLUG CONSISTED OF 1 SACK HULLS IN ONE RUBBER  
PLUG - 10 SACKS OF CEMENT ON TOP

PLUGGED DOWN AT 10:30 AM 9/12/81

(If additional description is necessary, use BACK of this sheet)

Name of Plugging Contractor GABBERT JONES, INC

STATE OF Nebraska COUNTY OF Lancaster, ss.  
ROGER C. RYANES - RESOURCE VENTURES CORP. (employee of owner) or (owner) or operator) of the above-described well, being first duly sworn on oath, says: That I have knowledge of the facts, statements, and matters herein contained and the log of the above-described well as filed and that the same are true and correct. So help me God.

(Signature) Roger C Ryanes  
1501 Superior Lincoln, Ne 68521  
(Address)

SUBSCRIBED AND SWORN TO before me this 25 day of September 1981

Kandice Kay Watermeier  
Notary Public.

My commission expires 2-12-83

