


Give Information Completely
Make Required Affidavit
or Deliver Report to:
Conservation Division
State Corporation Commission
211 No. Broadway
Wichita, Kansas

WELL PLUGGING RECORD

Ness County, Sec. 9 Twp. 16S Rge. 23 (E) West W)

Location as "NE/CNW/SW" or footage from lines 860' N. & 660' E. of Cen.
Lease Owner Cities Service Oil Company
Lease Name Smith "X" Well No. 1
Office Address Box 308, Great Bend, Kansas
Character of Well (completed as Oil, Gas or Dry Hole) Dry Hole
Date well completed August 6 1963
Application for plugging filed August 6 1963
Application for plugging approved August 6 1963
Plugging commenced August 6 1963
Plugging completed August 6 1963
Reason for abandonment of well or producing formation Dry Hole

NORTH

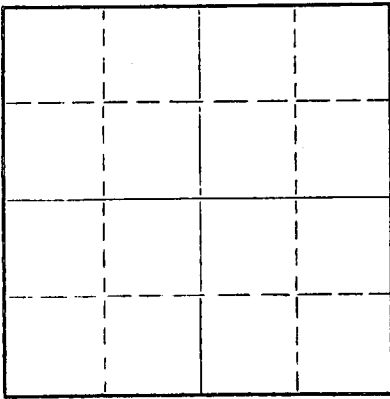

Locate well correctly on above
Section Plat

If a producing well is abandoned, date of last production -- 19--
Was permission obtained from the Conservation Division or its agents before plugging was commenced? Yes

Name of Conservation Agent who supervised plugging of this well Eldon Petty
Producing formation -- Depth to top -- Bottom -- Total Depth of Well 4448 Feet
Show depth and thickness of all water, oil and gas formations.

OIL, GAS OR WATER RECORDS

CASING RECORD

FORMATION	CONTENT	FROM	TO	SIZE	PUT IN	PULLED OUT
				8-5/8"	300'	None

Describe in detail the manner in which the well was plugged, indicating where the mud fluid was placed and the method or methods used in introducing it into the hole. If cement or other plugs were used, state the character of same and depth placed, from feet to feet for each plug set.

4448-550', mud.
550-491', wood plug and 20 sx cement.
491-240', mud.
240-181', wood plug and 20 sx cement.
181- 40', mud.
40'- 0', wood plug, hulls and 10 sx cement.

RECEIVED
STATE CORPORATION COMMISSION

SEP 13 1963
9-13-63
CONSERVATION DIVISION
Wichita, Kansas

(If additional description is necessary, use BACK of this sheet)

Name of Plugging Contractor Peel Brothers, Inc.
Address Box 359, Hoisington, Kansas

STATE OF Kansas, COUNTY OF Barton, ss.
John D. Forsyth (employee of owner) or (owner/proprietor) of the above-described well, being first duly sworn on oath, says: That I have knowledge of the facts, statements, and matters herein contained and the log of the above-described well as filed and that the same are true and correct. So help me God.

(Signature) John D Forsyth
Box 308, Great Bend, Kansas
(Address)

SUBSCRIBED AND SWORN TO before me this 8th day of August, 1963

My commission expires December 6, 1966
10-6-64

Lucille N. Schaffter
Notary Public.

WELL RECORD

15.135-19065-0000

Company Cities Service Oil Company Well No. 1 Farm Smith "X"
 Location 860' North and 660' East of Center Sec. 9 T. 16 R. 23W
 Elevation 2430 K.B., 2427 D.F., 2422 Gr. County Ness State Kansas
 Initial Prod. Dry hole. P. & A. 8-6-63. Contractor Peel Bros., Inc.
 Acid None Drlg. Comm. 7-22-63
 T. D. 4448' Drlg. Comp. 8-5-63

Casing Record:

8-5/8" @ 311' cement with 250 sacks.

Formation Record:

shale	0-15
shale and sand	25
shale and lime shells	260
shale	315
shale and shells	600
sand and shale	770
shale and shells	880
sand and shale	1065
shale and red bed	1500
red bed and shells	1768
Anhydrite	1810
shale and shells	1965
shale	2265
shale and shells	2395
shale and lime	2555
lime and shale	2671
lime	2885
lime and shale	3700
lime	4422
cherty lime	4448 T.D.

Top Topeka	3514
Top Heebner	3782
Top Lansing	3818
Base Kansas City	4105
Top Pawnee	4210
Top Fort Scott	4302
Top Cherokee	4326
Top Mississippi	4406
Pen.	42'
T.D.	4448

#1 D.S.T. 3910-39, open 1 hr. 10 mins.,
 rec. 1860' muddy salt water; IBHP 1340#
 in 30 mins., IF 86#, FF 770#, FBHP 1300#
 in 30 mins.

#2 D.S.T. 4308-33, open 1 hr. 40 mins.,
 rec. 78' o.c.m. & 63' o.c. muddy salt
 water; IBHP 1324# in 30 mins., IF 18#,
 FF 73#, FBHP 1160# in 45 mins.

#3 D.S.T. 4362-90, open 1 hr. 10 mins.,
 rec. 37' mud; IBHP 92# in 30 mins, IF
 9#, FF 19#, FBHP 37# in 30 mins.

#4 D.S.T. 4383-4422, open 1 hr. 10 mins,
 rec. 1690' muddy salt water; IBHP 1251#
 in 30 mins., IF 118#, FF 745#, FBHP
 1246# in 30 mins.

SLOPE TESTS (SYFO):

500'	- 1/4"
1000'	- 1/4"
1500'	- 1/4"
2000'	- 1/4"
2500'	- 1/4"
3000'	- 1/4"
3500'	- 1/4"

RECEIVED
 STATE CORPORATION COMMISSION

SEP 18 1963

CONSERVATION DIVISION
 Wichita, Kansas