

CARD MUST BE TYPED

State of Kansas
NOTICE OF INTENTION TO DRILL

CARD MUST BE SIGNED

(see rules on reverse side)

Starting Date: 12 12 85
month day year

API Number 15- 135-22,981-0000

OPERATOR: License # 9747

SW NE NW SE Sec 23 Twp 20 S, Rge 25 East West
(location)

Name Universal Resources Corp.

Address 1125 17th Suite 1800

City/State/Zip Denver, CO 80202

Contact Person David Kranz

Phone 303-296-8091

2145 Ft North from Southeast Corner of Section

1815 Ft West from Southeast Corner of Section

(Note: Locate well on Section Plat on reverse side)

CONTRACTOR: License # 6033

Name Murfin Drilling Company

City/State Wichita, KS

Nearest lease or unit boundary line 1815 feet.

County Ness

Lease Name Klein Well# 1

Domestic well within 330 feet: yes no

Municipal well within one mile: yes no

Well Drilled For: Well Class: Type Equipment:

Oil Swd Infield Mud Rotary

Gas Inj Pool Ext. Air Rotary

OWWO Expl Wildcat Cable

Depth to Bottom of fresh water 100 feet

Lowest usable water formation Dakota

Depth to Bottom of usable water 500 feet

Surface pipe by Alternate: 1 2

Surface pipe to be set 525 feet

Conductor pipe if any required N/A feet

Ground surface elevation feet MSL

This Authorization Expires 6-10-86

Approved By Ret 12-10-85

If OWWO: old well info as follows:

Operator

Well Name

Comp Date Old Total Depth

Projected Total Depth 4500 feet

Projected Formation at TD Miss.

Expected Producing Formations Miss.

I certify that we will comply with K.S.A. 55-101, et seq., plus eventually plugging hole to K.C.C. specifications.

Date 12-10-85 Signature of Operator or Agent

Rob Ramseyer
Rob Ramseyer, Agent for Operator


Title Ass't. Drlg. Mgr.

Must be filed with the K.C.C. five (5) days prior to commencing well
This card void if drilling not started within six (6) months of date received by K.C.C.

RECEIVED
STATE CORPORATION COMMISSION

DEC 10 1985
12-10-85

A Regular Section of Land CONSERVATION DIVISION
1 Mile = 5,280 Ft. Wichita, Kansas

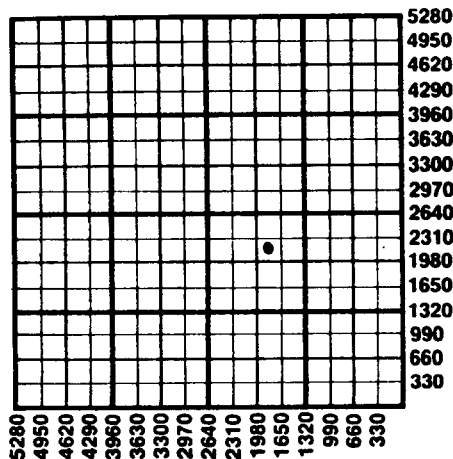

Important procedures to follow :

1. Notify District office before setting surface casing.
2. Set surface casing by circulating cement to the top.
3. File completion forms ACO-1 with K.C.C. within 90 days of well completion, following instructions on ACO-1, side 1, and including copies of wireline logs.
4. Notify District office 48 hours prior to old well workover or re-entry.
5. Prior to plugging, prepare a plugging plan, then obtain agreement from the appropriate district office for an approved plugging plan.
6. Submit plugging report (CP-4) to K.C.C. after plugging is completed.
7. Obtain an approved injection docket number before disposing of salt water.
8. Notify K.C.C. within 10 days when injection commences or terminates.
9. If an alternate 2 completion, cement in the production pipe from below any usable water to surface within 120 days of spud date.

State Corporation Commission of Kansas
Conservation Division
200 Colorado Derby Building
Wichita, Kansas 67202
(316) 263-3238