

CARD MUST BE TYPED

State of Kansas  
**NOTICE OF INTENTION TO DRILL**  
(see rules on reverse side)

CARD MUST BE SIGNED

Starting Date: October 29 1984  
month day year

API Number 15- 135-22,712-0000

OPERATOR: License # 5171

C SE NW  
(location) Sec 23 Twp 20 S, Rge 25  East  West

Name TXO Production Corp.

Address 200 West Douglas, Suite 300

City/State/Zip Wichita, KS 67202

Contact Person Gary Wurdeman

Phone 316-265-9441

3300 Ft North from Southeast Corner of Section  
3300 Ft West from Southeast Corner of Section  
(Note: Locate well on Section Plat on reverse side)

CONTRACTOR: License # 5422

Nearest lease or unit boundary line 660 feet.

County Ness

Name Abercrombie Drilling, Inc.

Lease Name FEHRENBACH Well# 1

City/State Wichita, KS 67202

Domestic well within 330 feet:  yes  no

Municipal well within one mile:  yes  no

Well Drilled For: Well Class: Type Equipment:

- Oil  Swd  Infield  Mud Rotary
- Gas  Inj  Pool Ext.  Air Rotary
- OWWO  Expl  Wildcat  Cable

Depth to Bottom of fresh water 100 400 MHC feet

Lowest usable water formation Cheyenne

Depth to Bottom of usable water 775 feet

If OWWO: old well info as follows:


Surface pipe by Alternate: 1  2

Surface pipe to be set 500 feet

Conductor pipe if any required 0 feet

Ground surface elevation TBD feet MSL

This Authorization Expires 4-24-85

Approved By 10-24-84 

Operator .....

Well Name .....

Comp Date ..... Old Total Depth .....

Projected Total Depth ..... feet

Projected Formation at TD .....

Expected Producing Formations .....

I certify that we will comply with K.S.A. 55-101, et seq., plus eventually plugging hole to K.C.C. specifications.

Date 10-22-84 Signature of Operator or Agent Gary Wurdeman


Title District Engineer

MHC/NOHE 10/24/84  
Form C-1 4/84

**Must be filed with the K.C.C. five (5) days prior to commencing well  
This card void if drilling not started within six (6) months of date received by K.C.C.**

**Important procedures to follow :**

**A Regular Section of Land  
1 Mile = 5,280 Ft.**

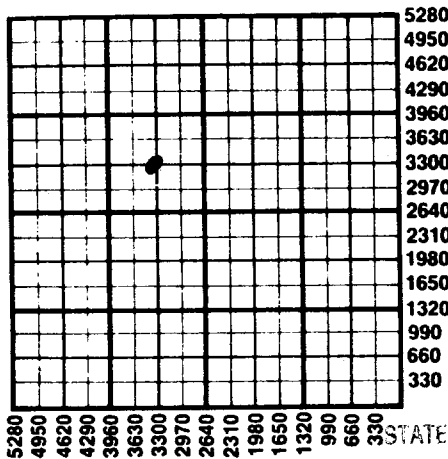

1. Notify District office before setting surface casing.
2. Set surface casing by circulating cement to the top.
3. File completion forms ACO-1 with K.C.C. within 90 days of well completion, following instructions on ACO-1, side 1, and including copies of wireline logs.
4. Notify District office 48 hours prior to old well workover or re-entry.
5. Prior to plugging, prepare a plugging plan, then obtain agreement from the appropriate district office for an approved plugging plan.
6. Submit plugging report (CP-4) to K.C.C. after plugging is completed.
7. Obtain an approved injection docket number before disposing of salt water.
8. Notify K.C.C. within 10 days when injection commences or terminates.
9. If an alternate 2 completion, cement in the production pipe from below any usable water to surface within 120 days of spud date.

RECEIVED

STATE CORPORATION COMMISSION

1007 24 1984  
10-24-84  
CONSERVATION DIVISION  
Wichita, Kansas

**State Corporation Commission of Kansas  
Conservation Division  
200 Colorado Derby Building  
Wichita, Kansas 67202  
(316) 263-3238**