


STATE OF KANSAS
STATE CORPORATION COMMISSION

WELL PLUGGING RECORD

Give All Information Completely
Make Required Affidavit
Mail or Deliver Report to
Conservation Division
State Corporation Comm.
245 North Water
Wichita, KS 67202

Rush County, Sec. 26 Twp. 18S Rge. 18W /2/4
Location as "NE/CNW/SW" or footage from lines
NE/4 NE/4 NW/4
Lease Owner W. C. Ogle, Jr.
Lease Name Oborny Well No. 1
Office Address 1108 North Green, Hoisington, Ks. 67544
Character of Well (Completed as Oil, Gas or Dry Hole) _____
D & A

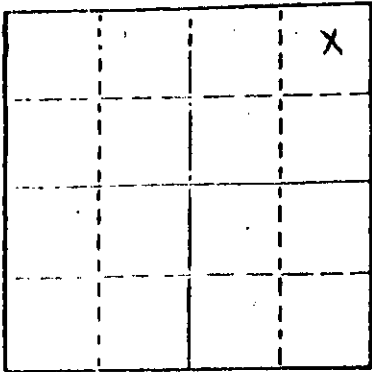

Date Well completed January 22, 1981
Application for plugging filed January 22, 1981
Application for plugging approved January 22, 1981
Plugging commenced January 22, 1981
Plugging completed January 22, 1981
Reason for abandonment of well or producing formation _____
D & A

If a producing well is abandoned, date of last production _____
19 _____

Was permission obtained from the Conservation Division or its agents before plugging was commenced? Yes

Name of Conservation Agent who supervised plugging of this well Leo F. Massey
Producing formation _____ Depth to top _____ Bottom _____ Total Depth of Well 3,778'
Show depth and thickness of all water, oil and gas formations.

OIL, GAS OR WATER RECORDS

CASING RECORD

FORMATION	CONTENT	FROM	TO	SIZE	PUT IN	PULLED OUT
				8 5/8"	1123.77'	-0-

Describe in detail the manner in which the well was plugged, indicating where the mud fluid was placed and the method or methods used in introducing it into the hold. If cement or other plugs were used, state the character of same and depth placed, from _____ feet to _____ feet for each plug set.

Plugged hole @ 600' w/50 sx cement
@ 300' w/30 sx cement
@ 40' w/10 sx cement
5 sx cement in rathole

(If additional description is necessary, use BACK of this sheet)

Name of Plugging Contractor Red Tiger Drilling Company
1720 KSB&T Building, Wichita, Kansas 67202

STATE OF Kansas COUNTY OF Sedgwick, ss. contractor
Gloria Fawcett (employee of ~~xxxxxx~~)

of the above-described well, being first duly sworn on oath, says: That I have knowledge of the facts, statements, and matters herein contained and the log of the above-described well as filed and that the same are true and correct. So help me God.

(Signature) Gloria Fawcett
1720 KSB&T Building, Wichita, Kansas 67202
(Address)

2-2-81
CONSERVATION DIVISION

SUBSCRIBED AND SWORN TO before me this 27th day of January, 1981.

My commission expires _____
Joyce A. Baer Notary Public.



15-165-20833-0000

DRILLERS LOG

No. 1 Oborny

CASING RECORD:	COMPANY:	W. C. Ogle, Jr.	DESCRIPTION:
8 5/8" @ 1,130' w/425 sx cement	CONTRACTOR:	Red Tiger Drilling Company	NE/4 NE/4 NW/4 Sec. 26-T18S-R18W Rush County, Kansas
D & A	COMMENCED:	January 12, 1981	
TOTAL DEPTH: 3,778'	COMPLETED:	January 22, 1981	ELEVATION: 1,989' GL

<u>FORMATION</u>	<u>FROM</u>	<u>TO</u>	<u>REMARKS</u>
Surface Soil	0	331	
Shale	331	552	
Sand	552	778	
Shale	778	1119	
Anhydrite	1119	1163	
Shale	1163	3050	
Shale & Lime	3050	3413	
Lime	3413	3778	
RTD		3778	

I certify that this is a true and correct copy of the above log to the best of my knowledge.

RED TIGER DRILLING COMPANY

Gloria Fawcett
Gloria Fawcett

Subscribed and sworn to before me this 27th day of January, 1981.

Joyce A. Baer
Notary Public



RECEIVED
FEB - 27
2-2-81
CONSERVATION