

15-165-01869-0000

STATE OF KANSAS
STATE CORPORATION COMMISSION


WELL PLUGGING RECORD

Give All Information Completely
Make Required Affidavit
Mail or Deliver Report to:
Conservation Division
State Corporation Commission
800 Biting Building
Wichita, Kansas

SE SE NE

County. Sec. 16 Twp. 18 Rge. (E) 18 (W)

NORTH

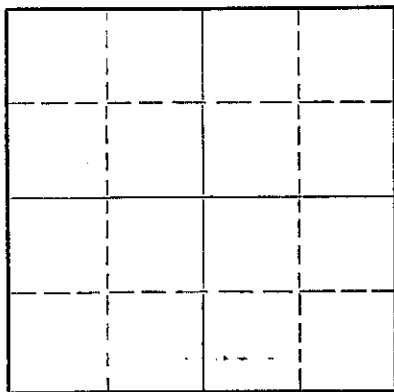

Locate well correctly on above
Section Flat

Location as "NE/CNW/SW" or footage from lines SE SE NE
Lease Owner E. H. Adair
Lease Name Dirks Well No. 2
Office Address 407 W-K-H Building, Wichita 2, Kansas
Character of Well (completed as Oil, Gas or Dry Hole) Dry Hole
Date well completed Feb. 11 1954
Application for plugging filed Feb. 11 1954
Application for plugging approved Feb. 11 1954
Plugging commenced Feb. 11 1954
Plugging completed Feb. 11 1954
Reason for abandonment of well or producing formation Barren

If a producing well is abandoned, date of last production 19
Was permission obtained from the Conservation Division or its agents before plugging was commenced? Yes

Name of Conservation Agent who supervised plugging of this well Warren H. Horner, Box 207, Great Bend, Ks.
Producing formation Depth to top Bottom Total Depth of Well 3886 Feet
Show depth and thickness of all water, oil and gas formations.

OIL, GAS OR WATER RECORDS

CASING RECORD

| FORMATION | CONTENT | FROM | TO | SIZE | PUT IN | PULLED OUT |
|---------------------------|---------|------|----|------|--------|------------|
| Copy of Well Log attached | | | | | | |
| | | | | | | |
| | | | | | | |
| | | | | | | |
| | | | | | | |
| | | | | | | |
| | | | | | | |
| | | | | | | |

Describe in detail the manner in which the well was plugged, indicating where the mud fluid was placed and the method or methods used in introducing it into the hole. If cement or other plugs were used, state the character of same and depth placed, from feet to feet for each plug set.

Placed plug at 300', mixed and paured thru drill pipe
20 sx cement, filled hole up to 35' of surface, placed
plug and 10 sx cement, filling hole to top.


2-24-54

(If additional description is necessary, use BACK of this sheet)
Name of Plugging Contractor E. H. Adair Oil Company,
Address Wichita 2, Kansas

STATE OF Kansas, COUNTY OF Sedgwick, ss.
E. H. Adair (employee of owner) or (owner or operator) of the above-described well, being first duly sworn on oath, says: That I have knowledge of the facts, statements, and matters herein contained and the log of the above-described well as filed and that the same are true and correct. So help me God.
(Signature) [Signature]
Wichita, Kansas (Address)

SUBSCRIBED AND SWORN to before me this 20th day of February, 1954

My commission expires September 15, 1957 Notary Public.

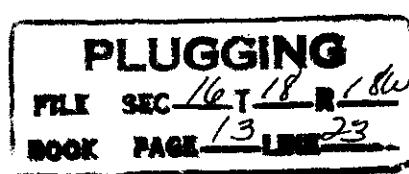

E. H. ADAIR OIL CO.
WICHITA 2, KANS.

E. H. Adair Oil Co. & Wm. Graham Oil Co.
Dirks # 2
SE SE NE 16-18-18W
Rush County, Kansas
elev. 2091 M

Coym. 1-27-54
under sfc. 1-31-54
Comp.
Cont. E. H. Adair
8 5/8 @ 990' w/500 car
Production: D & A

Bottom of Formation

Top

| | | |
|---|----|------|
| Shale and Shells | to | 125 |
| Shale | | 640 |
| Sand | | 892 |
| Red Shale | | 935 |
| Shale | | 990 |
| Shale and Shells | | 1247 |
| Anhydrite | | 1282 |
| Shale and Shells | | 1955 |
| Lime | | 2325 |
| Shale and Lime | | 2510 |
| Shale and Shells | | 3028 |
| Shale | | 3150 |
| Lime and Shale | | 3191 |
| Lime | | 3431 |
| Black Shale | | 3435 |
| Lime | | 3438 |
| Shale | | 3439 |
| Lime | | 3456 |
| Shale | | 3458 |
| Lime | | 3465 |
| Shale | | 3481 |
| Lime, K.C. | | 3488 |
| Shale | | 3500 |
| Lime | | 3504 |
| Lime, partly porous | | 3515 |
| Lime | | 3525 |
| Shale | | 3530 |
| Lime | to | 3541 |
| Lime w/shale streaks | | 3563 |
| Lime, cherty | | 3588 |
| Lime, dense | | 3586 |
| Lime, calcareous | | 3590 |
| Shale | | 3593 |
| Lime | | 3630 |
| Shale | | 3633 |
| Lime | | 3652 |
| Shale | | 3657 |
| Lime | | 3672 |
| Shale | | 3680 |
| calcareous, porous Lime | | 3686 |
| Lime, dense | | 3699 |
| Shale | | 3704 |
| Lime | | 3721 |
| Shale | | 3725 |
| Lime w/little shale | | 3732 |
| Shale | | 3735 |
| Lime w/little shale | to | 3749 |
| Varicolored Shale w/trace Lime | | 3763 |
| Shale | | 3767 |
| Cherty Lime | | 3771 |
| Shale w/little Lime | | 3781 |
| Cherty Lime | | 3786 |
| Shale | | 3794 |
| Cherty Lime | | 3810 |
| Varicolored Shale w/little sand | | 3814 |
| Cherty Lime | | 3838 |
| Chert, varicolored Shale & little sand | | 3878 |

| | |
|--------------|-----------|
| Anhydrite | |
| Topeka | |
| Hebner | 3431-3440 |
| Toronto | 3451-3460 |
| Lansing | 3484-3493 |
| Base K. C. | 3721-3730 |
| Conglomerate | 3838-3847 |
| Arbuskle | 3878-3887 |
| Total Depth | 3886 |

Delomite 3886
T. D. 3886

STATE OF KANSAS
FIELD NO. 10001
2-24-54

PLUGGING
WELL SEC. 16-T-18-R-116
BOOK PAGE 13 LINE 23