

15-165-01868-0000


STATE OF KANSAS
STATE CORPORATION COMMISSION

WELL PLUGGING RECORD

Give All Information Completely
Make Required Affidavit
Mail or Deliver Report to:
Conservation Division
State Corporation Commission
800 Bitting Building
Wichita, Kansas

RUSH County. Sec. 16 Twp. 18 Rge. 18 (E) W (W)

NORTH

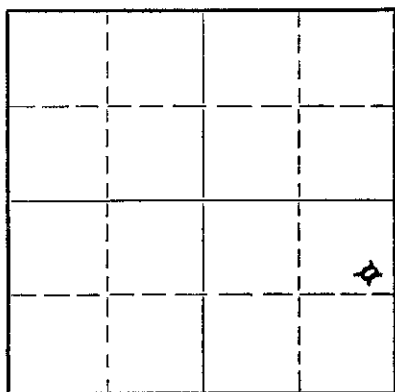

Locate well correctly on above
Section Plat

Location as "NE/CNW/SW" or footage from lines SE NE SE
Lease Owner GABBERT-JONES DRILLING CO.
Lease Name DIRKS Well No. 2
Office Address 514 ORPHEUM BUILDING - WICHITA, KANSAS
Character of Well (completed as Oil, Gas or Dry Hole) DRY HOLE
Date well completed 7-8-54 19
Application for plugging filed 7-8-54 (PHONE) 7-20 19 5/4
Application for plugging approved 7-8-54 (PHONE) 7-13 19 5/4
Plugging commenced 7-8-54 19
Plugging completed 7-8-54 19
Reason for abandonment of well or producing formation

If a producing well is abandoned, date of last production 19
Was permission obtained from the Conservation Division or its agents before plugging was commenced? YES

Name of Conservation Agent who supervised plugging of this well WARREN H. HORNER
Producing formation Depth to top Bottom Total Depth of Well 3859 Feet
Show depth and thickness of all water, oil and gas formations.

OIL, GAS OR WATER RECORDS

CASING RECORD

FORMATION	CONTENT	FROM	TO	SIZE	PUT IN	PULLED OUT
		0	1005	8 5/8	1005	NONE

Describe in detail the manner in which the well was plugged, indicating where the mud fluid was placed and the method or methods used in introducing it into the hole. If cement or other plugs were used, state the character of same and depth placed, from feet to feet for each plug set.

FILLED HOLE WITH HEAVY MUD TO 350 FEET, SET PLUG #1, WITH 20 SACKS CEMENT. FILLED HOLE TO 40 FEET, SET PLUG #2 WITH 15 SACKS CEMENT.

(If additional description is necessary, use BACK of this sheet)


Name of Plugging Contractor GABBERT-JONES DRILLING COMPANY
Address 514 ORPHEUM BUILDING, WICHITA, KANSAS

STATE OF Kansas, COUNTY OF SEDGWICK, ss.
C. J. Robert (employee of owner) or (owner or operator) of the above-described well, being first duly sworn on oath, says: That I have knowledge of the facts, statements, and matters herein contained and the log of the above-described well as filed and that the same are true and correct. So help me God.
(Signature) C. J. Robert

(Address)

SUBSCRIBED AND SWORN TO before me this 20TH day of JULY 19 54

My commission expires 10-27-54 Notary Public.

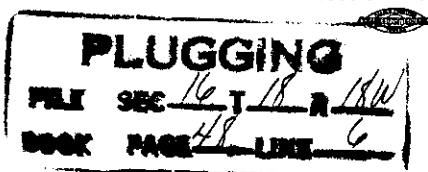

7-21-54

GABBERT-JONES DRILLING COMPANY
WICHITA, KANSAS
DRILLERS WELL LOG

DIRKS #2
 SE NE SE, SEC. 16-18-18
 RUSH COUNTY, KANSAS
 COMMENCED 6-27-54
 COMPLETED 7-8-54

DEPTH		FORMATION	REMARKS
FROM	TO		
0	240	SAND & SHALE	
240	455	SHALE & SHELLS	
455	540	BLUE SHALE	
540	560	SAND	
560	600	SHALE & SHELLS	
600	615	SHALE	
615	895	SAND & SHALE	
895	960	RED BED	
960	1005	SHALE & SHELLS	RAN 1005' OF 8 5/8" CASING CEMENTED W/475 SACKS CEMENT.
1005	1225	RED BED	
1225	1255	ANHYDRITE	
1255	1610	SHALE & SHELLS	
1610	1975	SHALE	
1975	2725	LIME	
2725	2995	LIME & SHALE	
2995	3175	SHALE & SHELLS	
3175	3285	LIME	
3285	3400	LIME & SHALE	
3400	3840	LIME	
3840	3859	CONGLOMERATE	
3859	TD		DRY & ABANDONED

EXECUTED THIS 20TH DAY OF JULY, 1954

C. L. Gabbert

STATE OF KANSAS)
) SS
 COUNTY OF SEDGWICK)

BEFORE ME, THE UNDERSIGNED, A NOTARY PUBLIC, WITHIN AND FOR SAID COUNTY AND STATE, ON THIS 20 DAY OF July, 1954 PERSONALLY APPEARED C. L. Gabbert TO ME PERSONALLY KNOWN TO BE THE IDENTICAL PERSON WHO EXECUTED THE WITHIN AND FOREGOING INSTRUMENT AND ACKNOWLEDGED TO ME THAT HE EXECUTED THE SAME AS HIS FREE AND VOLUNTARY ACT AND DEED FOR THE USES AND PURPOSES THEREIN SET FORTH.

IN WITNESS WHEREOF, I HAVE HEREUNTO SET MY HAND AND OFFICIAL SEAL THE DAY AND YEAR LAST ABOVE WRITTEN.

MY COMMISSION EXPIRES 10-27-54

Samuel E. Hall
 NOTARY PUBLIC

PLUGGING
 PLK SEC 16 T 18 R 18W
 BOOK PAGE 48 LINE 6

RECEIVED
 STATE DEPARTMENT OF REVENUE

JUL 21 1954
 7-21-54
 CONSERVATION DIVISION
 Wichita, Kansas