


Give All Information Completely
Make Required Affidavit
Mail or Deliver Report to:
Conservation Division
State Corporation Commission
211 No. Broadway
Wichita, Kansas

WELL PLUGGING RECORD

NORTH

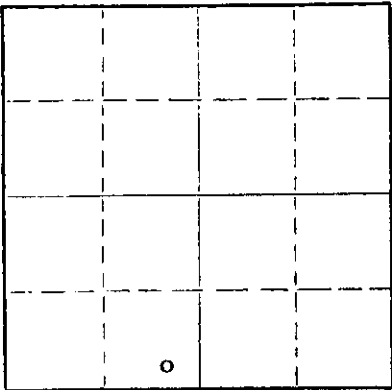

Locate well correctly on above
Section Plat

Rush County. Sec. 35 Twp. 18S Rge. (E) 18 (W)
Location as "NE/CNW%SW%" or footage from lines SE SE SW
Lease Owner Hellar Drilling Company, Inc.
Lease Name Bayer Well No. 1
Office Address 339 Union Center Bldg., Wichita, Kansas 67202
Character of Well (completed as Oil, Gas or Dry Hole) Dry Hole
Date well completed May 17 1973
Application for plugging filed May 17 1973
Application for plugging approved May 17 1973
Plugging commenced May 17 1973
Plugging completed May 17 1973
Reason for abandonment of well or producing formation Dry Hole

If a producing well is abandoned, date of last production 19
Was permission obtained from the Conservation Division or its agents before plugging was commenced? Yes

Name of Conservation Agent who supervised plugging of this well Leo F. Massey
Producing formation Depth to top Bottom Total Depth of Well 3875 Feet
Show depth and thickness of all water, oil and gas formations.

OIL, GAS OR WATER RECORDS

CASING RECORD

FORMATION	CONTENT	FROM	TO	SIZE	PUT IN	PULLED OUT
		0	334'	8 5/8"	334'	None

Describe in detail the manner in which the well was plugged, indicating where the mud fluid was placed and the method or methods used in introducing it into the hole. If cement or other plugs were used, state the character of same and depth placed, from feet to feet for each plug set.

Plug:

Plug hole thru Swedge w/150 sacks cement

RECEIVED
STATE CORPORATION COMMISSION
MAY 31 1973
5-31-73
CONSERVATION DIVISION
Wichita, Kansas

(If additional description is necessary, use BACK of this sheet)

Name of Plugging Contractor Hellar Drilling Company, Inc.
Address 339 Union Center Bldg., Wichita, Kansas 67202

STATE OF Kansas, COUNTY OF Sedgwick, ss.
D. L. Hellar, President of Hellar Drilg. Co. Inc.

(employee of owner) or (owner or operator) of the above-described well, being first duly sworn on oath, says: That I have knowledge of the facts, statements, and matters herein contained and the log of the above-described well as filed and that the same are true and correct. So help me God.

(Signature)

D. L. Hellar, President
339 Union Center Bldg., Wichita, Kansas 67202
(Address)

SUBSCRIBED AND SWORN to before me this 29th day of May, 19 73

My commission expires March 25, 1976

Catherine Darcey

Notary Public.

DRILLER'S LOG

COMPANY: Hellar Drilling Company, Inc., et al, Wichita, Kansas 67202
 CONTRACTOR: Hellar Drilling Company, Inc., Wichita, Kansas 67202
 LEASE: #1 Bayer
 LOCATION: SE SE SW 35-18S-18W, Rush County, Kansas
 COMMENCED: May 10, 1973
 COMPLETED: May 17, 1973
 CASING: Set 8 5/8" Surface Casing @ 334' w/225 sacks cement

0-270	Surface Soil, Clay & Post Rock
270-1201	Shale, Sand, Red Bed
1201-1236	Anhydrite
1236-1260	Shale
1260-2024	Shale & Red Bed & Salt
2024-2215	Lime & Shale
2215-2400	Lime (Ft. Riley)
2400-2567	Lime
2567-3188	Lime & Shale
3188-3330	Lime (Topeka)
3330-3526	Lime
3526-3556	Lime (L.K.C.)
3556-3716	Lime
3716-3833	Lime & Chert
3833-3875	Lime
3875	Rotary Total Depth

D & A

RECEIVED
 STATE CORPORATION COMMISSION
 MAY 31 1973
 5-31-73
 CONSERVATION DIVISION
 Wichita, Kansas

STATE OF KANSAS)
) SS
 COUNTY OF SEDGWICK)

I, D. L. Hellar, do hereby certify that the above and foregoing is a true and correct copy of the log of the #1 Bayer, located in SE SE SW 35-18S-18W, Rush County, Kansas, as reflected by the files of the Hellar Drilling Company, Inc.

HELLAR DRILLING COMPANY, INC.

By *D. L. Hellar*
 President - D. L. Hellar

Subscribed and sworn to before me, a Notary Public, in and for Sedgwick County, Kansas, this 29th day of May, 1973.

Catherine Darcey
 Notary Public - Catherine Darcey

My Commission Expires:
 March 25, 1976.