

15-165-20973-0000


STATE OF KANSAS
STATE CORPORATION COMMISSION
200 Colorado Derby Bldg.
Wichita, Kansas 67202

Form CP-4
Rev. 12-15-80

WELL PLUGGING RECORD

Give All Information Completely
Make Required Affidavit

COUNTY Rush SEC. 35 TWP. 18S RGE. 18W E/W
Location as in quarters or footage from lines:
N/2 SW NE

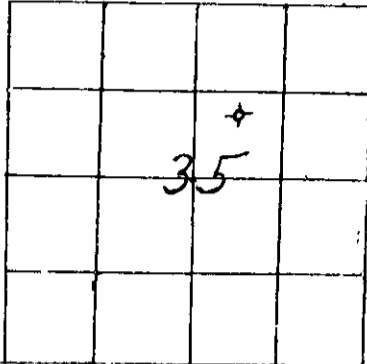

Lease Owner John Jay Darrah, Jr.
Lease Name Young Well No. 1
Office Address 405 Century Plaza, Wichita, Kansas 67202
Character of Well (Completed as Oil, Gas or Dry Hole): Dry Hole
Date Well Completed January 31, 1982
Application for plugging filed 2-16-82
Plugging commenced 1-31-82
Plugging completed 1-31-82
Reason for abandonment of well or producing formation Dry Hole

Locate Well
correctly on above
Section Platt.

Was permission obtained from the Conservation Division or it's
Agent's before plugging was commenced? Yes

Name of Conservation Agent who supervised plugging of this well Steve Durrant
Producing formation _____ Depth to top _____ bottom _____ T.D. 3843'
Show depth and thickness of all water, oil and gas formations.

OIL, GAS OR WATER RECORDS

Casing Record

Formation	Content	From	To	Size	Put In	Pulled Out
		0'	858'	8-5/8"	851'	None

Describe in detail the manner in which the well was plugged, indicating where the mud
fluid was placed and the method or methods used in introducing it into the hold. If cement
or other plugs were used, state the character of same and depth placed, from _____ feet
to _____ feet for each plug set.

Plugged with 60 sacks cement at 840';
50 sacks cement at 300'; bridge plug
and 10 sacks cement at 40'; and 10 sacks
cement in rat hole.

(If additional description is necessary, use BACK of this sheet)


Name of Plugging Contractor Allied Cementing Co.

STATE OF KANSAS COUNTY OF SEDGWICK, ss.
John D. Knightley, Agent (employee of owner) or (owner or operator) of the
above-described well, being first duly sworn on oath, says: That I have knowledge of the
facts, statements, and matters herein contained and the log of the above-described well as
filed and that the same are true and correct. So help me God.

(Signature) [Signature]
221 S. Broadway, Wichita, Kansas 67202
(Address)

SUBSCRIBED AND SWORN TO before me this 16th day of February, 1982

My Commission expires: March 12, 1983

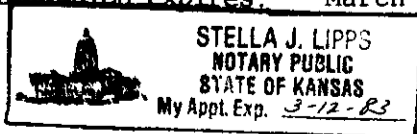

RECEIVED
STATE CORPORATION COMMISSION

2-18-82
FEB 18 1982

CONSERVATION DIVISION
Wichita Kansas

15-165-20973-0000

John Jay Darrah, Jr.
405 Century Plaza Bldg.
Wichita, Kansas 67202

-

Young #1
N/2 SW NE Sec. 35-18S-18W
Rush County, Kansas

Contractor: D. R. Lauck Oil Company, Inc.
221 S. Broadway, Suite 400
Wichita, Kansas 67202

Commenced: January 26, 1982
Completed: January 31, 1982

Drillers Log

Post Rock	40
Blue Shale	570
Sand	820
Red Bed	1192
Anhydrite	1221
Shale & Shells	3155
Shale & Lime	3835
Lime	3843 RTD

RECEIVED
STATE CORPORATION COMMISSION

FEB 18 1982
2-18-82
CONSERVATION DIVISION
Wichita Kansas