

This form shall be filed in duplicate with the Kansas Corporation Commission, 200 Colorado Derby Building, Wichita, Kansas 67202, within ten days after the completion of the well, regardless of how the well was completed.

Attach separate letter of request if the information is to be held confidential. If confidential, only file one copy. Information on side one will be of public record and side two will then be held confidential.

Circle one: Oil, Gas, Dry, SWD, OWWO, Injection. Type and complete ALL sections. Applications must be filed for dual completion, commingling, SWD and injection.

Attach wireline logs (i.e. electrical log, sonic log, gamma ray neutron log, etc.). KCC # (316) 263-3238. (Rules 82-2-105 & 82-2-125)

OPERATOR Attica Gas Venture Corp Inc

API NO. 15-077-20,902-00-00

ADDRESS 123 North Main  
Attica, Kansas 67009

COUNTY Harper

FIELD Sullivan

\*\*CONTACT PERSON P. John Eck  
PHONE 316 254-7222

PROD. FORMATION Stallnaker

PURCHASER Peoples Natural Gas

LEASE Attica

ADDRESS Suite 748 R. H. Garvey Bldg.  
Wichita, Kansas 67202

WELL NO. #3

WELL LOCATION Lot 11 & 12 Blk 57

DRILLING Gabbert-Jones Drilling Co.

175 Ft. from S Line and

CONTRACTOR ADDRESS 830 Sutton Place

1990 Ft. from W Line of

Wichita, Kansas

the SW SEC. 19 TWP. 32 RGE. 8W

PLUGGING N/A

CONTRACTOR ADDRESS

TOTAL DEPTH 3850 PBTD


SPUD DATE 5-19-83 DATE COMPLETED 9-8-83

ELEV: GR 1454 DF 1464 KB 1467

DRILLED WITH (CABLE) ROTARY (AIR) TOOLS

Amount of surface pipe set and cemented 57' 13 3/8 312' 8 5/8 DV Tool Used? no

WELL PLAT

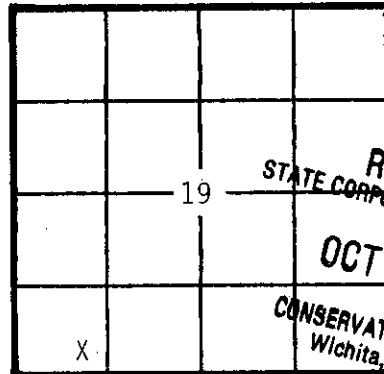

KCC [check] KGS [check] (Office Use)

RECEIVED STATE CORPORATION COMMISSION

OCT 6 1983

CONSERVATION DIVISION Wichita, Kansas

AFFIDAVIT

STATE OF Kansas, COUNTY OF Harper SS, I,

P. John Eck OF LAWFUL AGE, BEING FIRST DULY SWORN UPON HIS OATH,

DEPOSES THAT HE IS President (FOR) OF Attica Gas Venture Corp. Inc.

OPERATOR OF THE Attica LEASE, AND IS DULY AUTHORIZED TO MAKE

THIS AFFIDAVIT FOR AND ON THE BEHALF OF SAID OPERATOR, THAT WELL NO. 3 ON

SAID LEASE HAS BEEN COMPLETED AS OF THE 8th DAY OF September, 1983, AND THAT

ALL INFORMATION ENTERED HEREIN WITH RESPECT TO SAID WELL IS TRUE AND CORRECT.

FURTHER AFFIANT SAITH NOT.

(S) [Signature]

SUBSCRIBED AND SWORN BEFORE ME THIS 4th DAY OF October, 1983.

[Signature] NOTARY PUBLIC

MY COMMISSION [Stamp] 10-26-87

\*\*The person who can be reached by phone regarding any questions concerning this information. Within 45 days of completion, a witnessed initial test by the Commission is required if the well produces more than 25 BOPD or is located in a Basic Order Pool.

**SIDE TWO**

**WELL LOG**

Show all important zones of porosity and contents thereof; cored intervals, and all drill-stem tests, including depth interval tested, cushion used, time tool open, flowing and shut-in pressures, and recoveries.

SHOW GEOLOGICAL MARKERS, LOGS RUN, OR OTHER DESCRIPTIVE INFORMATION.

FORMATION DESCRIPTION, CONTENTS, ETC.	TOP	BOTTOM	NAME	DEPTH
Heebner	3386	-1919		
Douglas	3422	-1955		R A Guard Log
Iatan	3674	-2207		Neutron/ Density
Stalnaker Sand	3679	-2212		
RTD	3850			Porosity Log
No DST				

Report of all strings set — surface, intermediate, production, etc. **CASING RECORD** New or (Used)

Purpose of string	Size hole drilled	Size casing set (in O.D.)	Weight lbs/ft.	Setting depth	Type cement	Sacks	Type and percent additives
Surface		13 3/8	48	57'	Common	25	4% CC
Surface		8 5/8	24	312'	Common	225	2% Gel 3% CC
Casing		5 1/2	15 1/2	3846'	Surefill	150	1% Gel 6% JIP seal 3/4 of 1% CC

**LINER RECORD**

**PERFORATION RECORD**

Top, ft.	Bottom, ft.	Sacks cement	Shots per ft.	Size & type	Depth interval
			2	GeoVann	3692-3702
			2		3678-3686

**TUBING RECORD**

Size	Setting depth	Pecker set at
2 3/8	3567.58	

**ACID, FRACTURE, SHOT, CEMENT SQUEEZE RECORD**

Amount and kind of material used	Depth interval treated
none	

Date of first production 9-8-83	Producing method (flowing, pumping, gas lift, etc.) Flowing	Perforations 36
<b>RATE OF PRODUCTION PER 24 HOURS</b>	Oil bbls.	Gas 1,000 MCF
	Water %	Gas-oil ratio bbls. CFPB
Disposition of gas (vented, used on lease or sold) sold		