

This form shall be filed in duplicate with the Kansas Corporation Commission, 200 Colorado Derby Building, Wichita, Kansas 67202, within ten days after the completion of the well, regardless of how the well was completed.

Attach separate letter of request if the information is to be held confidential. If confidential, only file one copy. Information on side one will be of public record and side two will then be held confidential.

Circle one: Oil, Gas, Dry, SWD, OWWO, Injection. Type and complete ALL sections. Applications must be filed for dual completion, commingling, SWD and injection.

Attach wireline logs (i.e. electrical log, sonic log, gamma ray neutron log, etc.). KCC # (316) 263-3238. (Rules 82-2-105 & 82-2-125)

OPERATOR Attica Gas Venture Corporation

API NO. 15 077-20,744-00-00

ADDRESS 123 North Main Street

COUNTY Harper

Attica, Kansas 67009

FIELD Sullivan Ext.

**CONTACT PERSON P. John Eck

PROD. FORMATION Stalnaker

PHONE 316-254-7222

LEASE City of Attica #2

PURCHASER Peoples Natural Gas

WELL NO. 1

ADDRESS Suite 748 - R.H.Garvey Building

WELL LOCATION Lot 9, Block 67 Approx. CTR NE SE

300 W. Douglas, Wichita, Ks. 67202

660 Ft. from E/W Line and

DRILLING Gabbert & Jones Drilling Company

660 Ft. from N/S Line of

CONTRACTOR ADDRESS 830 Sutton Place

the SEC. 19 TWP. 32 RGE. 8

Wichita, Kansas 67202

PLUGGING N/A

CONTRACTOR ADDRESS

ADDRESS


TOTAL DEPTH 3727 PBTD Open hole

SPUD DATE 11-20-81 DATE COMPLETED 11-26-81

ELEV: GR 1468 DF 1472 KB 1482

DRILLED WITH (CABLE) (ROTARY) (AIR) TOOLS

Amount of surface pipe set and cemented 293 ft. DV Tool Used? No

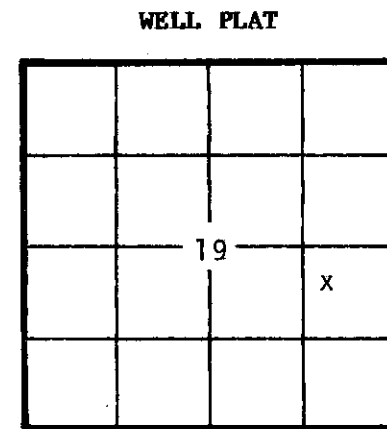

KCC [check] KGS [check] (Office Use)

A F F I D A V I T

STATE OF Kansas, COUNTY OF Harper SS, I,

P. John Eck OF LAWFUL AGE, BEING FIRST DULY SWORN UPON HIS OATH,

DEPOSES THAT HE IS President (FOR)(OF) Attica Gas Venture Corporation

OPERATOR OF THE City of Attica #2 LEASE, AND IS DULY AUTHORIZED TO MAKE

THIS AFFIDAVIT FOR AND ON THE BEHALF OF SAID OPERATOR, THAT WELL NO. 1 ON

SAID LEASE HAS BEEN COMPLETED AS OF THE 9th DAY OF December, 19 81, AND THAT

ALL INFORMATION ENTERED HEREIN WITH RESPECT TO SAID WELL IS TRUE AND CORRECT.

FURTHER AFFIANT SAITH NOT.

(S) [Signature] P. John Eck

SUBSCRIBED AND SWORN BEFORE ME THIS 15th DAY OF December, 19 81.

MARILYN DOWNING NOTARY PUBLIC STATE OF KANSAS MY COMMISSION EXPIRES: 10-4-85

MY COMMISSION EXPIRES:

NOTARY PUBLIC RECEIVED STATE CORPORATION COMMISSION

**The person who can be reached by phone regarding any questions concerning this information. Within 45 days of completion, a witnessed initial test by the Commission is required if the well produces more than 25 BOPD or is located in a Basic Order Pool.

12-16-81 STATE CORPORATION COMMISSION

SIDE TWO

WELL LOG

Show all important zones of porosity and contents thereof; cored intervals, and all drill-stem tests, including depth interval tested, cushion used, time tool open, flowing and shut-in pressures, and recoveries.

SHOW GEOLOGICAL MARKERS, LOGS RUN, OR OTHER DESCRIPTIVE INFORMATION.

FORMATION DESCRIPTION, CONTENTS, ETC.	TOP	BOTTOM	NAME	DEPTH
<p><u>Attaching</u></p> <p>Geologist's Report (Drilling Time & Sample log)</p> <p>No other logs made</p>				

Report of all strings set — surface, intermediate, production, etc. **CASING RECORD** (New) or (Used)

Purpose of string	Size hole drilled	Size casing set (in O.D.)	Weight lbs/ft.	Setting depth	Type cement	Sacks	Type and percent additives
Drillers We-1 Log Attached							
Engineer's Casing Record Attached							

LINER RECORD

PERFORATION RECORD

Top, ft.	Bottom, ft.	Sacks cement	Shots per ft.	Size & type	Depth interval
TUBING RECORD				Open hole completion	
Size	Setting depth	Packer set at			
Engineers Completion Record attached					

ACID, FRACTURE, SHOT, CEMENT SQUEEZE RECORD

Amount and kind of material used	Depth interval treated
None	

Date of first production Not on Production at this time	Producing method (flowing, pumping, gas lift, etc.) time	Gravity
RATE OF PRODUCTION PER 24 HOURS	Oil bbls.	Gas MCF
	Water %	Gas-oil ratio CFPB
Disposition of gas (vented, used on lease or sold)		Perforations