


STATE OF KANSAS
STATE CORPORATION COMMISSION

Give All Information Completely
Make Required Affidavit
Mail or Deliver Report to:
Conservation Division
State Corporation Commission
P. O. Box 17027
Wichita, Kansas 67217
NORTH

WELL PLUGGING RECORD

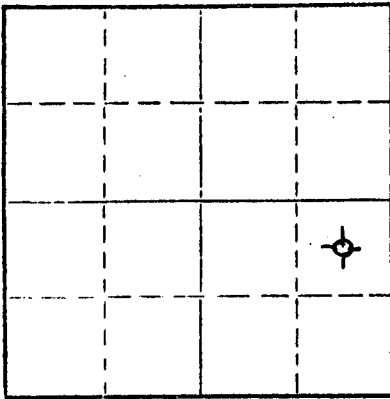

Locate well correctly on above
Section Plat

Barber County, Sec. 10 Twp. 32S Rge. (E) 11(W)
Location as "NE/CNW/SW" or footage from lines. 1980' FSL & 660' FEL
Lease Owner Texas Oil & Gas Corp.
Lease Name Stone Well No. 1
Office Address Suite 450, 200 W. Douglas, Wichita, Ka. 67202
Character of Well (completed as Oil, Gas or Dry Hole) Dry Hole
Date well completed February 21, 19 75
Application for plugging filed March 18, 19 75
Application for plugging approved March 19, 19 75
Plugging commenced March 20, 19 75
Plugging completed March 20, 19 75
Reason for abandonment of well or producing formation Dry Hole

If a producing well is abandoned, date of last production N/A 19
Was permission obtained from the Conservation Division or its agents before plugging was commenced? Yes

Name of Conservation Agent who supervised plugging of this well G. Russell Biberstein, Attica, Ka. 67009
Producing formation N/A Depth to top N/A Bottom N/A Total Depth of Well 4530 Feet
Show depth and thickness of all water, oil and gas formations.

OIL, GAS OR WATER RECORDS

CASING RECORD

FORMATION	CONTENT	FROM	TO	SIZE	PUT IN	PULLED OUT
		0'	371'	8-5/8"	371'	0'
		0	4529'	4-1/2"	4529'	3820'

Describe in detail the manner in which the well was plugged, indicating where the mud fluid was placed and the method or methods used in introducing it into the hole. If cement or other plugs were used, state the character of same and depth placed, from _____ feet to _____ feet for each plug set.

Set 4 sack plug in 4-1/2" csg @ 4290'. Cut off 4-1/2" csg @ 3820' and pulled csg. Set 10' rock bridge @ 240'. Dumped 4 yards ready mix concrete to surface.

RECEIVED
STATE CORPORATION COMMISSION

MAR 28 1975
3-28-75
CONSERVATION DIVISION
Wichita, Kansas

Name of Plugging Contractor Clarke Oilfield Service
Address 107 W. Fowler, Medicine Lodge, Kansas 67104

STATE OF KANSAS, COUNTY OF SEDGWICK, ss.
William C. Wells, Jr. (employee of owner) or (owner or operator) of the above-described well, being first duly sworn on oath, says: That I have knowledge of the facts, statements, and matters herein contained and the log of the above-described well as filed and that the same are true and correct. So help me God.

(Signature) William C. Wells, Jr.
Suite 450, 200 W. Douglas, Wichita, Ka.
(Address)

SUBSCRIBED AND SWORN TO before me this 27th day of March, 1975

My commission expires August 13, 1978

Sharron A. Richards
Notary Public.

15-007-20293-0000

DRILLERS' LOG

TEXAS OIL & GAS CORP.
No. 1 Stone
NE SE, Sec. 10-32S-11W
Barber, County, Kansas

Elev: 1535 K.B.

Commenced: 12-14-74
Completed: 12-29-74

Surface: 363/ of 8-5/8"
cemented w/325 sx common
cement, 3% cc. 12-15-74

FORMATION

DEPTH

Surface Hole	0 - 371
Red Bed & Shale	371 - 473
Shale & Red Bed	473 - 1400
Shale, Red Bed w/ Li Strks	1400 - 1745
Shale & Lime	1745 - 2150
Lime & Shale	2150 - 3095
Lime	3095 - 3260
Lime & Shale	3260 - 3625
Lime	3625 - 4440
Lime & Shale	4440 - 4520
Lime	4520 - 4530 T.D.

I do hereby certify that the foregoing statements are true and correct to the best of my knowledge and belief.

D N B DRILLING, INC.

James L. Donelson
JAMES L. DONELSON

STATE OF KANSAS: ss:

Subscribed and sworn to before me, the undersigned, a Notary Public in and for said state, this 27th day of January, 1975.

My Commission Expires:
August 25, 1976

Ella Priess
Ella Priess, Notary Public

RECEIVED

Ella Priess
STATE NOTARY PUBLIC
Sedgwick County, Kansas
My Com. Expires Aug. 25, 1976