


STATE OF KANSAS
STATE CORPORATION COMMISSION

WELL PLUGGING RECORD

Give All Information Completely
Make Required Affidavit
Mail or Deliver Report to
Conservation Division
State Corporation Comm.
245 North Water
Wichita, KS 67202

Rush County. Sec. 17 Twp. 19S Rge. 16W E/W
Location as "NE/CNW 1/4 SW 1/4" or footage from lines _____
SE SE SW

Lease Owner W. E. Carl and APC, Inc.
Lease Name Hagerman Well No. 1-17
Office Address 600 One Main Pl., Wichita, KS 67202
Character of Well (Completed as Oil, Gas or Dry Hole) _____
DRY HOLE

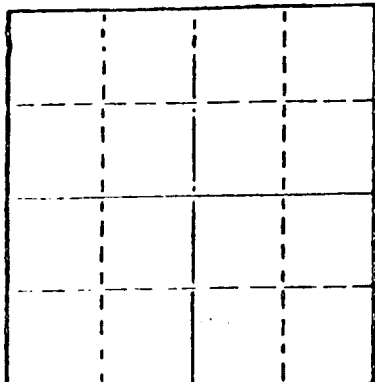

Locate well correctly on above
Section Plat

Date Well completed October 28, 1980
Application for plugging filed October 28, 1980
Application for plugging approved October 28, 1980
Plugging commenced October 28, 1980
Plugging completed October 28, 1980

Reason for abandonment of well or producing formation _____
DRY HOLE
If a producing well is abandoned, date of last production _____
19 _____

Was permission obtained from the Conservation Division or
its agents before plugging was commenced? YES

Name of Conservation Agent who supervised plugging of this well Marion Schmidt
Producing formation _____ Depth to top _____ Bottom _____ Total Depth of Well 13,910'
Show depth and thickness of all water, oil and gas formations.

OIL, GAS OR WATER RECORDS

CASING RECORD

FORMATION	CONTENT	FROM	TO	SIZE	PUT IN	PULLED OUT
				8-5/8"	401'	

Describe in detail the manner in which the well was plugged, indicating where the mud fluid
was placed and the method or methods used in introducing it into the hold. If cement or other
plugs were used, state the character of same and depth placed, from _____ feet to
_____ feet for each plug set.

Mud to 660', 70 sacks cement
Mud to 270', 20 sacks cement
Mud to 40, plug, 1/4 sack hulls
10 sack cement
5 sacks in rathole

RECEIVED
STATE CORPORATION COMMISSION

NOV - 5 1980

11-5-80
CONSERVATION DIVISION
Wichita, Kansas

(If additional description is necessary, use BACK of this sheet)

Name of Plugging Contractor _____

STATE OF Kansas COUNTY OF Sedgwick
(employee of owner) or (~~owner~~ or operator)

of the above-described well, being first duly sworn on oath, says: That I have knowledge of
the facts, statements, and matters herein contained and the log of the above-described well
as filed and that the same are true and correct. So help me God.

(Signature) Donald E. [Signature]
Suite 250, 200 West Douglas, Wichita, KS 67202
(Address)

SUBSCRIBED AND SWORN TO before me this 30th day of October, 19 80

My commission expires January 4, 1981

Kathleen L. Greger
Kathleen L. Greger Notary Public.

