

Give All Information Completely
Make Required Affidavit
Mail or Deliver Report to:
Conservation Division
State Corporation Commission
212 No. Market
Wichita, Kansas

WELL PLUGGING RECORD

Rush County. Sec. 16 Twp. 19S Rge. (E) 16 (W)

Location as "NE/CNW/SW" or footage from lines NE SE SW

Lease Owner Oscar L. Stutenroth

Office Address Peoples State Bank Bldg., Ellinwood, Kansas

Character of Well (completed as Oil, Gas or Dry Hole) oil

Date well completed 6-20 19 65

Application for plugging filed 6-17 19 66

Application for plugging approved 6-17 19 66


Plugging commenced 6-17 19 66

Plugging completed 6-17 19 66

Reason for abandonment of well or producing formation depleted

If a producing well is abandoned, date of last production _____ 19 _____

Was permission obtained from the Conservation Division or its agents before plugging was commenced? yes

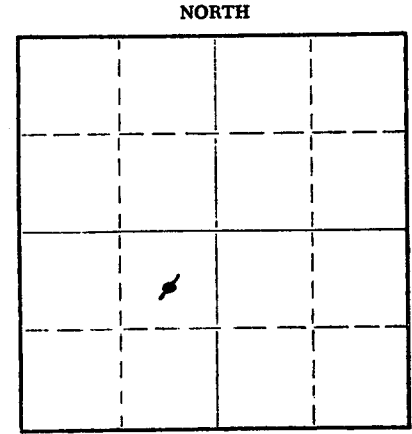

Locate well correctly on above Section Plat

Name of Conservation Agent who supervised plugging of this well Leo Massey

Producing formation _____ Depth to top _____ Bottom _____ Total Depth of Well 3792 Feet

Show depth and thickness of all water, oil and gas formations.

OIL, GAS OR WATER RECORDS

CASING RECORD

FORMATION	CONTENT	FROM	TO	SIZE	PUT IN	PULLED OUT
		0	235'	8 5/8"	235'	none
		0	3792'	4 1/2"	3792	3161'

Describe in detail the manner in which the well was plugged, indicating where the mud fluid was placed and the method or methods used in introducing it into the hole. If cement or other plugs were used, state the character of same and depth placed, from _____ feet to _____ feet for each plug set.

Filled with sand - 3720' 3 sacks 3720' - 3684'
17 sacks of jel mud and 100 sacks of cement in 8 5/8" casing.

RECEIVED
STATE CORPORATION COMMISSION
JUL 25 1966
7-25-66
CONSERVATION DIVISION
WICHITA, KANSAS

(If additional description is necessary, use BACK of this sheet)
Name of Plugging Contractor Glenn & Smith Pipe Pulling Company
Address Box 156, Ellinwood, Kansas

STATE OF Kansas, COUNTY OF Barton, ss.
Oscar L. Stutenroth (employee of owner) or (owner or operator) of the above-described

well, being first duly sworn on oath, says: That I have knowledge of the facts, statements, and matters herein contained and the log of the above-described well as filed and that the same are true and correct. So help me God.

(Signature) Oscar L. Stutenroth

Ellinwood, Kansas
(Address)

SUBSCRIBED AND SWORN TO before me this 22 day of July, 19 66

[Signature]
Notary Public.

My commission expires July 7, 1968