


STATE OF KANSAS  
STATE CORPORATION COMMISSION

Form CP-4

Give All Information Completely  
Make Required Affidavit  
Mail or Deliver Report to:  
Conservation Division  
State Corporation Commission  
P. O. Box 17027  
Wichita, Kansas 67217  
NORTH

WELL PLUGGING RECORD

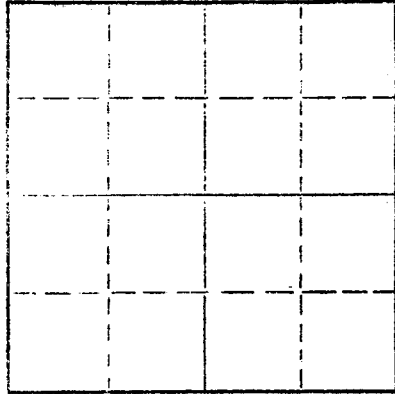

Locate well correctly on above  
Section Plat

Rush County. Sec. 13 Twp. 19 Rge. 16 (W) (W)  
Location as "NE/CNW/SW" or footage from lines C SW NE  
Lease Owner Al Tipton  
Lease Name S. Miller Well No. 2  
Office Address Box 157, Hays, Kansas  
Character of Well (completed as Oil, Gas or Dry Hole) Dry Hole  
Date well completed October 2 19 73  
Application for plugging filed October 2 19 73  
Application for plugging approved October 2 19 73  
Plugging commenced October 2 19 73  
Plugging completed October 2 19 73  
Reason for abandonment of well or producing formation \_\_\_\_\_

If a producing well is abandoned, date of last production \_\_\_\_\_ 19 \_\_\_\_\_  
Was permission obtained from the Conservation Division or its agents before plugging was commenced? yes

Name of Conservation Agent who supervised plugging of this well Don B Truan  
Producing formation \_\_\_\_\_ Depth to top \_\_\_\_\_ Bottom \_\_\_\_\_ Total Depth of Well 3763 Feet  
Show depth and thickness of all water, oil and gas formations.

OIL, GAS OR WATER RECORDS

CASING RECORD

FORMATION	CONTENT	FROM	TO	SIZE	PUT IN	PULLED OUT

Describe in detail the manner in which the well was plugged, indicating where the mud fluid was placed and the method or methods used in introducing it into the hole. If cement or other plugs were used, state the character of same and depth placed, from \_\_\_\_\_ feet to \_\_\_\_\_ feet for each plug set.

Hole full of heavy mud.  
Set Plug at 400' with 30 sacks cement thru drill pipe.  
Come up hole to 40' -set plug, 1/2 sacks & 10 sacks cement.  
2 sacks cement in rat hole.

RECEIVED  
STATE CORPORATION COMMISSION  
OCT 4 1973  
10-4-73  
CONSERVATION DIVISION  
Wichita, Kansas

(If additional description is necessary, use BACK of this sheet)

Name of Plugging Contractor \_\_\_\_\_  
Address \_\_\_\_\_

STATE OF Kansas COUNTY OF Barton, ss.  
Leonard Williamson (employee of owner) or (~~owner~~) of the above-described

well, being first duly sworn on oath, says: That I have knowledge of the facts, statements, and matters herein contained and the log of the above-described well as filed and that the same are true and correct. So help me God.

(Signature) Leonard Williamson  
Box 823 - Great Bend, Kansas 67530  
(Address)

SUBSCRIBED AND SWORN to before me this 2nd day of October, 19 73.

Barth M. Hogue  
Notary Public.

My commission expires April 11, 1974

15-165-20479-0000

DRILLERS' WELL LOG

DATE COMMENCED: September 23, 1973  
DATE COMPLETED: October 2, 1973

Al Tipton  
S. MILLER #2  
C SW NE  
Sec. 13-T19S-R16W  
Rush County, Kansas  
ELEVATION: 2023 K.B.

0	-	45'	Clay & Post Rock
45	-	165'	Shale
165	-	210'	Sand
210	-	365'	Shale & Sand Streaks
365	-	595'	Sand
595	-	710'	Shale & Sand Streaks
710	-	1041'	Red Bed
1041	-	1075'	Anhydrite
1075	-	1340'	Red Bed
1340	-	1885'	Shale & Shells
1885	-	2992'	Lime & Shale
2992	-	3033'	Lime
3033	-	3052'	Shale
3052	-	3300'	Lime
3300	-	3304'	Shale
3304	-	3315'	Lime & Shale
3315	-	3329'	Lime
3329	-	3371'	Shale
3371	-	3382'	Lime & Shale
3382	-	3613'	Lime
3613	-	3644'	Lime & Shale
3644	-	3749'	Lime, Shale, Chert & Sand
3749	-	3763'	Sand
		3763'	RTD

FORMATION DATA

ANHYDRITE	1041
HOWARD	2992
SEVERY	3033
TOPEKA	3052
HEEBNER	3300
TORONTO	3315
DOUGLAS	3329
BR. LIME	3371
KANSAS CITY	3382
BASE K.C.	3613
CONGLOMERATE	3644
REGAN SAND	3749

SURFACE PIPE: Set new  
8-5/8" pipe, 20# at 1054'  
with 380 sacks cement.

A F F I D A V I T

STATE OF KANSAS  
COUNTY OF BARTON ) ss.

Leonard Williamson of lawful age does swear and state that  
the facts and statements herein contained are true and correct to the  
best of his knowledge.

Leonard Williamson

Subscribed and sworn to before me this 2nd day of October 1973.

My Comm. Expires:  
April 11, 1974

Heath M. Hague  
Notary Public

RECEIVED  
STATE CORPORATION COMMISSION  
OCT 4 1973  
10-4-73  
CONSERVATION DIVISION  
Wichita, Kansas