


STATE OF KANSAS  
STATE CORPORATION COMMISSION

WELL PLUGGING RECORD

Give All Information Completely  
Make Required Affidavit  
Mail or Deliver Report to  
Conservation Division  
State Corporation Comm.  
245 North Water  
Wichita, KS 67202

Rush County. Sec. 12 Twp. 19 Rge. 16 NE  
Location as "NE/CNW $\frac{1}{4}$ SW $\frac{1}{4}$ " or footage from lines \_\_\_\_\_

C/NE/SE  
Lease Owner The Roxana Corporation  
Lease Name Miller "A" Well No. 1  
Office Address Box 1162 Great Bend, KS 67530  
Character of Well (Completed as Oil, Gas or Dry Hole) \_\_\_\_\_

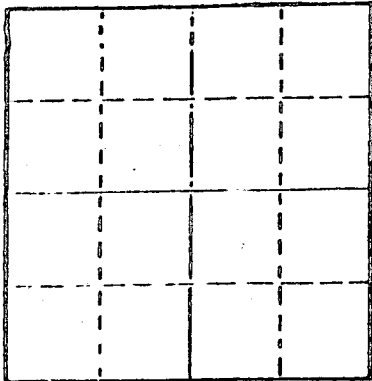

Locate well correctly on above  
Section Plot

oil  
Date Well completed \_\_\_\_\_ 19\_\_\_\_  
Application for plugging filed \_\_\_\_\_ 19\_\_\_\_  
Application for plugging approved \_\_\_\_\_ 19\_\_\_\_  
Plugging commenced \_\_\_\_\_ April 16 1979  
Plugging completed \_\_\_\_\_ April 21 1979  
Reason for abandonment of well or producing formation \_\_\_\_\_

Depleted  
If a producing well is abandoned, date of last production \_\_\_\_\_ 19\_\_\_\_

Was permission obtained from the Conservation Division or its agents before plugging was commenced? Yes

Name of Conservation Agent who supervised plugging of this well Leo Massey  
Producing formation \_\_\_\_\_ Depth to top \_\_\_\_\_ Bottom \_\_\_\_\_ Total Depth of Well 3636'  
Show depth and thickness of all water, oil and gas formations.

OIL, GAS OR WATER RECORDS

CASING RECORD

FORMATION	CONTENT	FROM	TO	SIZE	PUT IN	PULLED OUT
				8 5/8"	1010'	NONE
				5 1/2"	3635'	1973.72'

Describe in detail the manner in which the well was plugged, indicating where the mud fluid was placed and the method or methods used in introducing it into the hold. If cement or other plugs were used, state the character of same and depth placed, from \_\_\_\_\_ feet to \_\_\_\_\_ feet for each plug set.

Dumped sand to 3575' with five (5) sacks cement  
Shot casing at 3000', 2900', 2800', 2600', 2400', 2200', 2100', & 2000'  
Pulled 51 joints of 5 1/2" casing.  
Built rock bridge at 300' and plugged well with 3 1/2 yards of ready-mix concrete

(If additional description is necessary, use BACK of this sheet)

Name of Plugging Contractor Rockhold Engineering, Inc.

STATE OF KANSAS COUNTY OF BARTON, ss.  
James W. Rockhold (employee of owner) or (owner or operator)  
of the above-described well, being first duly sworn on oath, says: That I have knowledge of the facts, statements, and matters herein contained and the log of the above-described well as filed and that the same are true and correct. So help me God.

(Signature) James W. Rockhold

James W. Rockhold Box 698, Great Bend, KS 67530  
(Address)

SUBSCRIBED AND SWORN TO before me this 24<sup>th</sup> day of April, 1979

STATE NOTARY PUBLIC  
CATHY L. COLE  
Barton County, Kansas  
My Appt. Expires June 14, 1982

Cathy L. Cole  
Notary Public.

My commission expires \_\_\_\_\_

RECEIVED  
STATE CORPORATION COMMISSION

APR 25 1979  
4-25-79  
CONSERVATION DIVISION  
Wichita, Kansas

DRILLERS' WELL LOG

DATE COMMENCED: March 7, 1976  
 DATE COMPLETED: March 14, 1976

Icer Addis  
 MILLER A-1  
 C NE SE  
 Sec 12-T19S-R16W  
 Rush County, Kansas

ELEVATION: 1988 K.B.

FORMATION TOPS

0 - 40'	Surface Clay
40 - 435'	Shale
435 - 540'	Sand
540 - 1002'	Red Bed, Shale
1002 - 1036'	Anhydrite
1036 - 1710'	Red Bed, Shale
1710 - 1840'	Shale, Lime, Shells
1840 - 2971'	Lime and Shale
2971 - 2989'	Shale, Sand
2989 - 3231'	Lime
3231 - 3235'	Shale
3235 - 3262'	Lime and Shale
3262 - 3302'	Shale
3302 - 3313'	Lime and Shale
3313 - 3543'	Lime
3543 - 3576'	Lime and Shale
3576 - 3605'	Lime, Shale, Chert, Sand
3605 - 3636'	Sand
3636'	RTD

Anhydrite	1002
Severy	2971
Topeka	2989
Heebner	3231
Douglas	3262
Brown Lime	3302
Kansas City	3313
Base K.C.	3543
Cong.	3576
Reagan	3605
RTD	3636

SURFACE PIPE:  
 Set 1010' of used 8 5/8", 28#  
 pipe w/200 sacks 50/50 Pozmix,  
 2% Gel, 3% cc & 175 sacks Common,  
 2% Gel, 3% cc.

PRODUCTION PIPE:  
 Ran used 14#, 5 1/2" casing @ 3635'  
 w/15 bbl salt flush & 125 sacks  
 60/40 Pozmix, salt sat.

A F F I D A V I T

STATE OF KANSAS }  
 COUNTY OF BARTON } ss.

Leonard Williamson, of lawful age, does swear and state that the facts and statements herein contained are true and correct to the best of his knowledge.

*Leonard Williamson*

Subscribed and sworn to before me this 16th day of March, 1976.

*Alvin M. Hagne*  
 Notary Public

My Commission Expires: April 11, 1978

RECEIVED  
 STATE CORPORATION COMMISSION  
 FEB 21 1979  
 2-21-79  
 CONSERVATION DIVISION  
 Wichita, Kansas