

WELL PLUGGING RECORD

Give All Information Completely
Make Required Affidavit
Mail or Deliver Report to:
Conservation Division
State Corporation Commission
211 No. Broadway
Wichita, Kansas

Rush County, Sec. 12 Twp. 19S Rge. (X) 16 (W)

Location as "NE/CNW/SW" or footage from lines c SW SE

Lease Owner Al Tipton

Lease Name E. Miller Well No. 1

Office Address Box 157, Hays, Kansas 67601

Character of Well (completed as Oil, Gas or Dry Hole) Dry Hole

Date well completed July 18 19 73

Application for plugging filed July 18 19 73

Application for plugging approved July 18 19 73


Plugging commenced July 18 19 73

Plugging completed July 18 19 73

Reason for abandonment of well or producing formation Dry Hole

If a producing well is abandoned, date of last production 19

Was permission obtained from the Conservation Division or its agents before plugging was commenced? yes

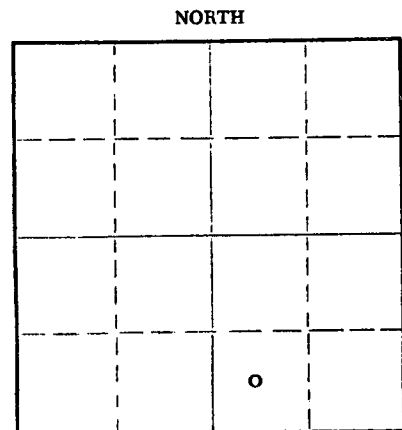

Locate well correctly on above Section Plat

Name of Conservation Agent who supervised plugging of this well Leo F. Massey

Producing formation Depth to top Bottom Total Depth of Well 3700 Feet

Show depth and thickness of all water, oil and gas formations.

OIL, GAS OR WATER RECORDS

CASING RECORD

FORMATION	CONTENT	FROM	TO	SIZE	PUT IN	PULLED OUT
		0	1039'	8 5/8"	1039'	None

Describe in detail the manner in which the well was plugged, indicating where the mud fluid was placed and the method or methods used in introducing it into the hole. If cement or other plugs were used, state the character of same and depth placed, from feet to feet for each plug set.

Plug: 300' w/25 sacks cement
40' w/10 sacks cement

RECEIVED
STATE CORPORATION COMMISSION
7-23-73
JUL 23 1973
CONSERVATION DIVISION
Wichita, Kansas

(If additional description is necessary, use BACK of this sheet)

Name of Plugging Contractor Hellar Drilling Company, Inc.

Address 339 Union Center Bldg., Wichita, Kansas 67202

STATE OF Kansas, COUNTY OF Sedgwick, ss.

D. L. Hellar, Pres. of Hellar Drlg. Co. Inc (employee of owner) or (owner or operator) of the above-described well, being first duly sworn on oath, says: That I have knowledge of the facts, statements, and matters herein contained and the log of the above-described well as filed and that the same are true and correct. So help me God.


(Signature) D. L. Hellar D. L. Hellar, President
339 Union Center Bldg., Wichita, Kansas 67202

(Address)

SUBSCRIBED AND SWORN TO before me this 20th day of July, 19 73

Catherine Darcey
Catherine Darcey - Notary Public.

March 25, 1976

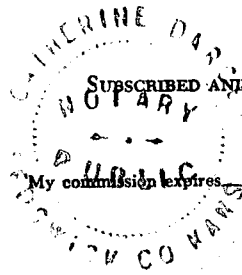

DRILLER'S LOG

COMPANY: Al Tipton, Box 157, Hays, Kansas 67601
 CONTRACTOR: Hellar Drilling Company, Inc., Wichita, Kansas 67202
 LEASE: #1 E. Miller
 LOCATION: c SW SE 12-19S-16W, Rush County, Kansas
 COMMENCED: July 9, 1973
 COMPLETED: July 18, 1973
 CASING: Set 8 5/8" Surface Casing @ 1039' w/380 sacks cement

0-363	Surface Soil
363-464	Shale
464-568	Sand
568-1010	Shale - Red Bed - Sand
1010-1030	Red Bed
1030-1057	Anhydrite
1057-1245	Shale
1245-1876	Shale & Salt Section
1876-2145	Shale & Lime
2145-2298	Lime (Ft. Riley)
2298-2461	Lime
2461-3008	Lime & Shale
3008-3133	Lime & Shale (Topeka)
3133-3313	Lime
3313-3426	Lime w/Shale Streaks
3426-3665	Lime
3665-3700	Reagan Sand
3700	Rotary Total Depth

D & A

RECEIVED
 STATE CORPORATION COMMISSION
 JUL 23 1973
 7-23-73
 CONSERVATION DIVISION
 Wichita, Kansas

STATE OF KANSAS)
) SS
 COUNTY OF SEDGWICK)

I, D. L. Hellar, do hereby certify that the above and foregoing is a true and correct copy of the log of the #1 E. Miller, located in c SW SE 12-19S-16W, Rush County, Kansas, as reflected by the files of the Hellar Drilling Company, Inc.

HELLAR DRILLING COMPANY, INC.

By *D. L. Hellar*
 President - D. L. Hellar

Subscribed and sworn to before me, a Notary Public, in and for Sedgwick County, Kansas, this 20th day of July, 1973.

Catherine Darcey
 Notary Public - Catherine Darcey



My Commission Expires:
 March 25, 1976.