


WELL PLUGGING RECORD

Give All Information Completely  
Make Required Affidavit  
Mail or Deliver Report to:  
Conservation Division  
State Corporation Commission  
800 Bitting Building  
Wichita, Kansas

NORTH

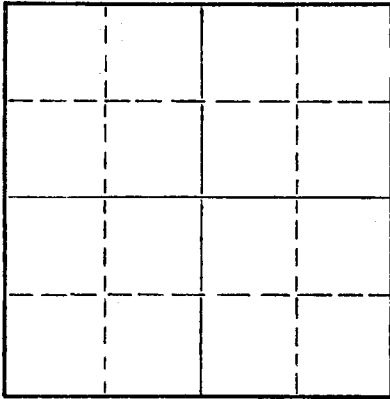

Locate well correctly on above  
Section Plat

Barber County. Sec. 11 Twp. 32S Rge. 11 (E) W (W)  
Location as "NE/CNW%SW%" or footage from lines NW SE SW  
Lease Owner Beardmore Drilling Company  
Lease Name Schiff Well No. 1  
Office Address 827 Beacon Building  
Character of Well (completed as Oil, Gas or Dry Hole) Dry Hole  
Date well completed 2-28 1957  
Application for plugging filed 2-28 1957  
Application for plugging approved 2-28 1957  
Plugging commenced 2-28 1957  
Plugging completed 2-28 1957  
Reason for abandonment of well or producing formation Dry Hole

If a producing well is abandoned, date of last production \_\_\_\_\_ 19\_\_\_\_  
Was permission obtained from the Conservation Division or its agents before plugging was commenced? Yes

Name of Conservation Agent who supervised plugging of this well M. A. Rives  
Producing formation \_\_\_\_\_ Depth to top \_\_\_\_\_ Bottom \_\_\_\_\_ Total Depth of Well 4483 Feet  
Show depth and thickness of all water, oil and gas formations.

OIL, GAS OR WATER RECORDS

CASING RECORD

FORMATION	CONTENT	FROM	TO	SIZE	PUT IN	PULLED OUT
<u>Sand</u>		<u>0</u>	<u>20'</u>			
		<u>20'</u>	<u>205'</u>	<u>8-5/8"</u>	<u>205'</u>	<u>0</u>

Describe in detail the manner in which the well was plugged, indicating where the mud fluid was placed and the method or methods used in introducing it into the hole. If cement or other plugs were used, state the character of same and depth placed, from \_\_\_\_\_ feet to \_\_\_\_\_ feet for each plug set.

0 to 35' - 10 sacks cement

35' - Wood plug

35 to 150' - Heavy mud

150 to 200' - 20 sacks cement

200' - Wood Plug

200 to 4483' - Heavy mud

(If additional description is necessary, use BACK of this sheet)

Name of Plugging Contractor Beardmore Drilling Company  
Address 827 Beacon Building, Wichita, Kansas

STATE OF KANSAS, COUNTY OF SEDGWICK, ss.  
Heber Beardmore (employee of owner) or (owner or operator) of the above-described well, being first duly sworn on oath, says: That I have knowledge of the facts, statements, and matters herein contained and the log of the above-described well as filed and that the same are true and correct. So help me God, BEARDMORE DRILLING COMPANY

(Signature) By [Signature]  
827 Beacon Building  
(Address)

SUBSCRIBED AND SWORN to before me this 7th day of March, 1957

My commission expires January 28, 1960

Leonard P. Tolle Notary Public.  
STATE CORPORATION COMMISSION

PLUGGING  
FILE SEC 11 T. 32 R. 11W  
BOOK PAGE 145 LINE 7

MAR 11 1957  
3-11-57  
CONSERVATION DIVISION  
Wichita, Kansas

BEARDMORE-BARBARA  
 #1 Schiff  
 NW SE SW Section 11-32S-11W  
 Barber County, Kansas

Drilled By: Beardmore Drilling Company  
 Drilling Commenced: 2-15-57  
 Drilling Completed: 2-28-57

Casing Record:  
 Ran 207' of 8-5/8" set at 205' with 130 sacks. Cement circulated.  
 2-15-57.

Elevations: KB 1535  
 DF 1532  
 Gr 1529

<u>FORMATIONS</u>	<u>DEPTH</u>
Cellar	5
Sand	20
Red Rock and Shale	205
Shale and Shells	1500
Shale and Lime	1725
Shale and Lime	2425
Shale and Lime	2935
Shale and Lime	3245
Shale and Lime	3565
Shale and Lime	3605
Shale and Sand	3625
Shale and Lime	3715
Shale and Lime	3865
Lime	3910
Lime	4060
Lime	4125
Shale and Lime	4180
Shale and Lime	4230
Lime	4250
Shale and Lime	4325
Shale and Lime	4450
Lime	4483
Rotary Total Depth	4483

TOPS

Heebner	3602
Top Snyderville Sand Zone	3617
Base " " " " "	3638
Lansing	3770
Top Pennsylvanian Sand Zone	4413
Mississippi	4428

CORE #1 3605-3614 - Recovered 9'

CORE #2 4414-4425 - Recovered 11'

STATE OF KANSAS }  
 COUNTY OF SEDGWICK } ss

I, the undersigned, being duly sworn on oath state that the above and within statement is a true and correct record and log of the well drilled on the location above described, to the best of my knowledge and belief.

*Robert J. [Signature]*

Subscribed and sworn to before me this 5th day of March 1957.

*Leonard P. Tolle*  
 Leonard P. Tolle  
 Notary Public  
 STATE CORPORATION COMMISSION

My Commission Expires:  
 January 28, 1960

PLUGGING  
 FILE SEC 11 T 32 R 11W  
 BOOK PAGE 145 LINE 7

MAR 11 1957  
 3-11-57  
 CONSERVATION DIVISION  
 Wichita, Kansas