


STATE OF KANSAS  
STATE CORPORATION COMMISSION

Give All Information Completely  
Make Required Affidavit  
Mail or Deliver Report to:  
Conservation Division  
State Corporation Commission  
211 No. Broadway  
Wichita, Kansas

WELL PLUGGING RECORD

NORTH

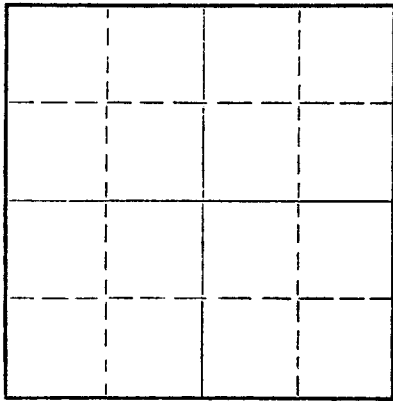

Locate well correctly on above  
Section Plat

Barber County. Sec. 11 Twp. 32 Rge. 11 (E) (W)  
Location as "NE/CNW/SW" or footage from lines SW/SW/NW  
Lease Owner Jones, Shelburne & Farmer, Inc.  
Lease Name Schiff Well No. #1  
Office Address Russell, Kansas  
Character of Well (completed as Oil, Gas or Dry Hole) \_\_\_\_\_  
Date well completed \_\_\_\_\_ 19\_\_\_\_  
Application for plugging filed Yes 19\_\_\_\_  
Application for plugging approved Yes 19\_\_\_\_  
Plugging commenced \_\_\_\_\_ 4-8 19 57  
Plugging completed \_\_\_\_\_ 4-12 19 57  
Reason for abandonment of well or producing formation \_\_\_\_\_

If a producing well is abandoned, date of last production \_\_\_\_\_ 19\_\_\_\_  
Was permission obtained from the Conservation Division or its agents before plugging was commenced? Yes

Name of Conservation Agent who supervised plugging of this well Mr. M.A. Rives  
Producing formation \_\_\_\_\_ Depth to top \_\_\_\_\_ Bottom \_\_\_\_\_ Total Depth of Well 4450' Feet  
Show depth and thickness of all water, oil and gas formations.

OIL, GAS OR WATER RECORDS

CASING RECORD

FORMATION	CONTENT	FROM	TO	SIZE	PUT IN	PULLED OUT
				5 1/2"		3,494'

Describe in detail the manner in which the well was plugged, indicating where the mud fluid was placed and the method or methods used in introducing it into the hole. If cement or other plugs were used, state the character of same and depth placed, from \_\_\_\_\_ feet to \_\_\_\_\_ feet for each plug set.

Measured into TD 3494'.  
Plugging started 4-8-57. Finished 4-12-57.  
Plugged off bottom with sand to 4390' and dumped 5 sacks cement with bailer.  
Shot 5 1/2" casing at 3494'. Pulled pipe out of hole and plugged well with heavy mud to 225' and set permanent rock bridge. Dumped 20 sacks cement.  
Filled hole with heavy mud to 35' and mixed 10 sacks cement for cap on well.

(If additional description is necessary, use BACK of this sheet)

Name of Plugging Contractor J.O. Forbes d/b/a Forbes Casing Pulling Co.  
Address Box 221, Great Bend, Kansas

STATE OF Kansas, COUNTY OF Barton, ss.  
J.O. Forbes (employee of owner) or (owner or operator) of the above-described well, being first duly sworn on oath, says: That I have knowledge of the facts, statements, and matters herein contained and the log of the above-described well as filed and that the same are true and correct. So help me God.

(Signature) J. O. Forbes  
Box 221, Great Bend, Kansas (Address)

SUBSCRIBED AND SWORN TO before me this 15th day of April, 1957.

My commission expires November 8, 1960.  
Betty S. Edman Notary Public.

RECEIVED  
STATE CORPORATION COMMISSION

PLUGGING  
FILE SEC 11 T 32 R 11W  
BOOK PAGE 148 LINE 34

APR 16 1957  
4-16-57  
CONSERVATION DIVISION  
Wichita, Kansas


**OPERATOR Jones, Shelburne & Farmer, Inc.**

**ADDRESS Russell, Kansas**

**FORMATION RECORD**

Give detailed description and thickness of all formations drilled through, contents of sand, whether dry, water, oil or gas.

15-007-00393-0000  
WELL NO. 1 COUNTY Barber SEC. 11 TWP. 32 RGE. 11

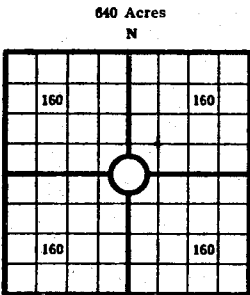

640 Acres  
N  
COUNTY Barber, SEC. 11, TWP. 32, RGE. 11  
COMPANY OPERATING Jones, Shelburne & Farmer, Inc.  
OFFICE ADDRESS Russell, Kansas  
FARM NAME SCHIFF B WELL NO. 1  
DRILLING STARTED 12-5, 19 56 DRILLING FINISHED 12-24 19 56  
DATE OF FIRST PRODUCTION \_\_\_\_\_ COMPLETED \_\_\_\_\_  
WELL LOCATED SW 1/4 SW 1/4 NW 1/4 North of South  
Line and \_\_\_\_\_ ft. East of West Line of Quarter Section  
Elevation (Relative to sea level) DERRICK FLOOR 1539 GROUND 1535  
CHARACTER OF WELL (Oil, gas or dryhole) Gas

**OIL OR GAS SANDS OR ZONES**

Name	From	To	Name	From	To
1			4		
2			5		
3			6		

**Perforating Record If Any**

**Shot Record**

Formation	From	To	No. of Shots	Formation	From	To	Size of Shot

**CASING RECORD**

Amount Set						Amount Pulled		Packer Record	
Size	Wt.	Thds.	Make	Ft.	In.	Ft.	In.	Size	Length
8-5/8				238					

Liner Record: Amount \_\_\_\_\_ Kind \_\_\_\_\_ Top \_\_\_\_\_ Bottom \_\_\_\_\_

**CEMENTING AND MUDDING**

Size	Amount Set		Sacks Cement	Chemical		Method of Cementing	Amount	Mudding Method	Results (See Note)
	Ft.	In.		Gal.	Make				
2 1/2	238		175						
5-1/2	4449		150						

Note: What method was used to protect sands if outer strings were pulled? \_\_\_\_\_

NOTE: Were bottom hole plugs used? \_\_\_\_\_ If so, state kind, depth set and results obtained \_\_\_\_\_

**TOOLS USED**

Rotary Tools were used from \_\_\_\_\_ feet to \_\_\_\_\_ Cable tools were used from \_\_\_\_\_ feet to \_\_\_\_\_ feet, and from \_\_\_\_\_ feet to \_\_\_\_\_ feet, and from \_\_\_\_\_ feet to \_\_\_\_\_ feet to \_\_\_\_\_

Type Rig \_\_\_\_\_

**INITIAL PRODUCTION TEST**

Describe initial test: whether by flow through tubing or casing or by pumping \_\_\_\_\_

Amount of Oil Production \_\_\_\_\_ bbls. Size of choke, if any \_\_\_\_\_ Length of test \_\_\_\_\_ Water Production \_\_\_\_\_ bbls. Gravity of oil \_\_\_\_\_ Type of Pump if pump is used, describe \_\_\_\_\_

Formation	Top	Bottom	Formation	Top	Bottom
Shale & sand	0	135			
Redbed & shale	135	238			
Redbed sand & shale	238	563			
Shale & shells	563	1450			
Shale & lime	1450	1625			
Lime & shale	1625	1800			
Lime	1800	2100			
Lime & shale	2100	2210			
Shale & lime	2210	2370			
Lime & shale	2370	2500			
Shale & lime	2500	2640			
Lime & shale	2640	2795			
Shale & lime	2795	3135			
Lime	3135	3220			
Shale & lime	3220	3305			
Lime & shale	3305	3370			
Shale & lime	3370	3615			
Sand	3615	3630			
Shale & sand	3630	3655			
Lime & shale	3655	3730			
Shale & lime	3730	3800			
Lime	3800	4441			
Mississippi T.D.	4441	4450			
					4450

PLUGGING  
FILE SEC. 11 T. 32 R. 11W  
BOOK PAGE 149 LINE 34

ELEVATION 1540 RB

**HALLIBURTON ELECTRIC LOG TOPS:**

Heebner	3592
Upper Douglas	3610
Toronto	3657
Douglas shale	3688
Brown Lime	3757
Lansing/Kansas City	3774
B/Kansas City	4220
Cherokee sand	4403
Mississippi chert	4410
Halliburton T.D.	4451
5-1/2" set 1 foot off bottom with 150 sacks cement	

RECEIVED  
MAR 12 1958  
CONV. DIVISION  
KANSAS

I, the undersigned, being first duly sworn upon oath, state that this well record is true, correct and complete according to the records of this office and to the best of my knowledge and belief.

*John D. Farmer* Vice-Pres.  
Name and title of representative of company

Subscribed and sworn to before me this 27th day of December, 19 56  
My Commission expires 10-11-58  
*Lucille K. ...*  
Notary Public.