


Give All Information Completely
Make Required Affidavit
Mail or Deliver Report to:
Conservation Division
State Corporation Commission
211 No. Broadway
Wichita, Kansas

WELL PLUGGING RECORD

NORTH

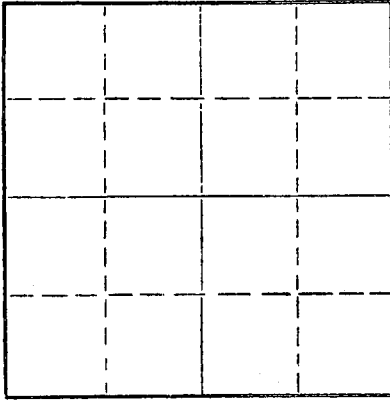

Locate well correctly on above
Section Plat

Ness County, Sec. 29 Twp. 20S Rge. 25W (E) (W)
Location as "NE/CNW/SW" or footage from lines C NW SE
Lease Owner Ferguson Oil Company
Lease Name Slagle Well No. 1
Office Address 427 Union Center, Wichita, Kansas
Character of Well (completed as Oil, Gas or Dry Hole) D & A
Date well completed July 22, 19 61
Application for plugging filed July 22, 19 61
Application for plugging approved July 22, 19 61
Plugging commenced July 22, 19 61
Plugging completed July 22, 19 61
Reason for abandonment of well or producing formation D & A

If a producing well is abandoned, date of last production _____ 19 ____
Was permission obtained from the Conservation Division or its agents before plugging was commenced? Yes

Name of Conservation Agent who supervised plugging of this well Gilbert P. Leiker
Producing formation _____ Depth to top _____ Bottom _____ Total Depth of Well _____ Feet
Show depth and thickness of all water, oil and gas formations.

OIL, GAS OR WATER RECORDS

CASING RECORD

FORMATION	CONTENT	FROM	TO	SIZE	PUT IN	PULLED OUT
				8 5/8"	543'	-0-

Describe in detail the manner in which the well was plugged, indicating where the mud fluid was placed and the method or methods used in introducing it into the hole. If cement or other plugs were used, state the character of same and depth placed, from _____ feet to _____ feet for each plug set.

Filled hole with mud to 540'
Set bottom plug with 1/2 sx
hulls and 20 sx cement. Set
top plug at 40' with 1/2 sx
hulls and 10 sx cement.

RECEIVED
STATE CORPORATION COMMISSION
AUG 3 1961
8-3-61
CONSERVATION DIVISION
WICHITA, KANSAS

(If additional description is necessary, use BACK of this sheet)

Name of Plugging Contractor Red Tiger Drilling Company
Address Box 173 - Russell, Kansas

STATE OF KANSAS, COUNTY OF SEDGWICK, ss.
Roy McClure (employee of owner) or (~~owner~~) of the above-described well, being first duly sworn on oath, says: That I have knowledge of the facts, statements, and matters herein contained and the log of the above-described well as filed and that the same are true and correct. So help me God.

(Signature) Roy McClure

580 Fourth National Bank Bldg., Wichita, Ks.
(Address)

SUBSCRIBED AND SWORN TO before me this 26th day of July, 19 61

Dorrie Head

Notary Public.

My commission expires 11-17-62



15135-00162-0000

DRILLERS LOG

Stagle No. 1

CASING RECORD: 8 5/8" @ 543' w/235 cc cement
 COMPANY: Ferguson Oil Company
 CONTRACTOR: Red Tiger Drilling Co.
 COMMENCED: July 9, 1961
 COMPLETED: July 22, 1961
 DESCRIPTION: C NW SE
 29-209-23W
 Ness County
 Kansas
 ELEVATION: 2405 DF
 2408 RB
 TOTAL DEPTH: 4460'

<u>FORMATION</u>	<u>FEET</u>	<u>TO</u>	<u>REMARKS</u>
Clay & Sand	0	40	
Shale & Lime	40	205	
Shale & Shells	205	995	
Anhydrite	995	1020	
Shale Shells	1020	1100	
Sand Shale	1100	1320	
Shale & Shells	1320	1622	
Anhydrite	1622	1865	
Shale & Shells	1865	2095	
Shale Lime	2095	2750	
Lime	2750	2870	
Lime & Shale	2870	3605	
Lime	3605	3675	
Lime & Shale	3675	3770	
Lime	3770	4285	
Lime & Shale	4285	4335	
Lime	4335	4380	
Cherty Lime	4380	4414	
Lime	4414	4460	

RECEIVED
 STATE CORPORATION COMMISSION
 AUG 3 1961
 CONSERVATION DIVISION
 Wichita, Kansas

I certify that this is a true and correct copy of the above log to the best of my knowledge.

RED TIGER DRILLING COMPANY

Roy McClure
 Roy McClure

Subscribed and sworn to before me this 24th day of July, 1961.

Minnie Shad
 Notary Public

My Commission Expires:

11-17-62