


STATE OF KANSAS
STATE CORPORATION COMMISSION

WELL PLUGGING RECORD

Give All Information Completely
Make Required Affidavit
Mail or Deliver Report to
Conservation Division
State Corporation Comm.
245 North Water
Wichita, KS 67202

Rush County. Sec. 30 Twp. 19S Rge. 20 E/W
Location as "NE/CNW $\frac{1}{4}$ SW $\frac{1}{4}$ " or footage from lines
C SE SE

Lease Owner Pickrell Drilling Company
Lease Name Dehner "C" Well No. 1
Office Address 205 Litwin Bldg., Wichita, Kansas 67202
Character of Well (Completed as Oil, Gas or Dry Hole) oil

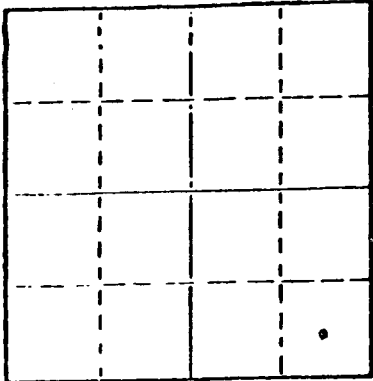

Locate well correctly on above
Section Plat

Date Well completed 19
Application for plugging filed Dec. 30 1976
Application for plugging approved 19
Plugging commenced Feb. 17 1977
Plugging completed Feb. 22 1977
Reason for abandonment of well or producing formation depleted

If a producing well is abandoned, date of last production 19

Was permission obtained from the Conservation Division or
its agents before plugging was commenced? yes

Name of Conservation Agent who supervised plugging of this well Leo Massey
Producing formation _____ Depth to top _____ Bottom _____ Total Depth of Well 4395'
Show depth and thickness of all water, oil and gas formations.

OIL, GAS OR WATER RECORDS

CASING RECORD

FORMATION	CONTENT	FROM	TO	SIZE	PUT IN	PULLED OUT
			270'	8 5/8"	270'	none
			4390'	5 1/2"	4390'	3226.27

Describe in detail the manner in which the well was plugged, indicating where the mud fluid
was placed and the method or methods used in introducing it into the hold. If cement or other
plugs were used, state the character of same and depth placed, from _____ feet to
_____ feet for each plug set.

Sanded back to 4380' and dumped 4 sacks of cement.

Pumped in 1 sack of hulls, 25 sacks of gel and 100 sacks of cement.

RECEIVED

STATE CORPORATION COMMISSION

3-3-77
MAR 03 1977

(If additional description is necessary, use BACK of this sheet)

Name of Plugging Contractor PIPE PULLERS, INC.
Box 128, Ellinwood, Kansas 67526

STATE OF KANSAS COUNTY OF BARTON, ss.
Evelyn Roth (employee of owner) or (~~owner or operator~~)
of the above-described well, being first duly sworn on oath, says: That I have knowledge of
the facts, statements, and matters herein contained and the log of the above-described well
as filed and that the same are true and correct. So help me God.

(Signature) Evelyn Roth
Ellinwood, Kansas
(Address)

SUBSCRIBED AND SWORN TO before me this 28th day of February, 19 77

My commission expires _____

JENNY KASSELMAN
NOTARY PUBLIC
BARTON COUNTY, KANSAS
MY COMM. EXP. JULY 16, 1978

Jenny Kasselmann
Notary Public.

15-169-20375-0000
NOTARY DRILLING LOG

COMPANY: Pickrell Drilling Company
705 Fourth National Bank Building
Wichita, Kansas 67202

Rotary Drilling Commenced 2/14/71

Rotary Drilling Completed 2/24/71

LOCATION: Dehner "C" No. 1, C SE SE Section 30-19S-20W,
Rush County, Kansas

CONTRACTOR: **PICKRELL DRILLING COMPANY**
Wichita, Kansas

CASING RECORD: Run 13 Jts. 8-5/8" surface casing set @ 270' KB. Cemented with 150 sacks. Completed 1:15 P.M. Circulated.

Ran 138 Jts. 5-1/2" Casing set @ 4395'. Cemented with 125 sacks. Plug down at 5:20 P.M. February 24, 1971.

LOG

(Figures indicate bottom of formation — measurements from top of rotary bushing.)

130	Post Rock - Clay	
344	Shale & Shells	C. F. S.
750	Shale & Sand Streaks	4335
895	Red Bed	4375
1110	Sand	4395
1470	Red Bed & Shale	
1479	Shale - Shells	
1510	Anhydrite	
1880	Shale - Shells	S. L. M.
2260	Shale w/Lime Streaks	Board, 4386.99
2295	Lime & Shale	Strap 4386.16
2890	Lime	.83 Short
3220	Lime & Shale	
3425	Shale & Lime	
3600	Lime - Shale	
3833	Shale & Lime	Slope Tests
4375	Lime	2000
4395	Lime - Chert, RTD	2500
		3000
		3500
		4000

RECEIVED
STATE CORPORATION COMMISSION

JAN 04 1977
1-4-77
CONSERVATION DIVISION
Wichita, Kansas

The undersigned, C. W. Sebitts, Attorney-in-Fact for PICKRELL DRILLING COMPANY, hereby certifies in behalf of said Company, that the above is a true and correct log of the formation encountered in drilling the above well as reflected by the Daily Drilling Reports.

PICKRELL DRILLING COMPANY
By C. W. Sebitts Attorney-in-Fact

STATE OF KANSAS }
COUNTY OF SEDGWICK } ss.:

On this 8th day of March, 19 71, before me the undersigned, a Notary Public, in and for

County and State aforesaid, personally appeared C. W. Sebitts, to me known to be the identical person who subscribed the name of PICKRELL DRILLING COMPANY to the foregoing instrument as its Attorney-in-Fact and acknowledged to me that he executed the same as his free and voluntary act and deed, and as the free and voluntary act and deed of such company, for the uses and purposes therein set forth.

Given under my hand and seal of office the day and year last above written.

My commission expires: January 19, 1973

Esther Lamone
Esther Lamone Notary Public

