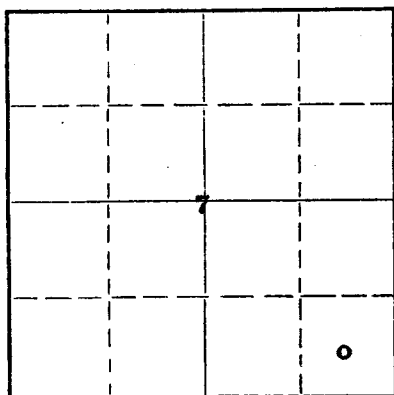


Give All Information Completely
Make Required Affidavit
Mail or Deliver Report to:
Conservation Division
State Corporation Commission
212 North Market, Insurance Bldg.
Wichita, Kansas

WELL PLUGGING RECORD

NORTH

Locate well correctly on above
Section Plat

Ness County. Sec. 7 Twp. 20S Rge. 25W (E) (W)
Location as "NE/CNW/SW" or footage from lines C SE SE
Lease Owner Hellar Drilling Company, Inc.
Lease Name Gibson Well No. 1
Office Address 1014 Union Center, Wichita, Kansas
Character of Well (completed as Oil, Gas or Dry Hole) Dry Hole
Date well completed March 31, 19 61
Application for plugging filed March 31, 19 61
Application for plugging approved March 31, 19 61
Plugging commenced March 31, 19 61
Plugging completed March 31, 19 61
Reason for abandonment of well or producing formation Dry Hole

If a producing well is abandoned, date of last production 19
Was permission obtained from the Conservation Division or its agents before plugging was commenced? Yes, orally

Name of Conservation Agent who supervised plugging of this well Gilbert Leiker
Producing formation _____ Depth to top _____ Bottom _____ Total Depth of Well 4565 Feet
Show depth and thickness of all water, oil and gas formations.

OIL, GAS OR WATER RECORDS

CASING RECORD

FORMATION	CONTENT	FROM	TO	SIZE	PUT IN	PULLED OUT
		0	438'	8 5/8"	448.60'	None

Describe in detail the manner in which the well was plugged, indicating where the mud fluid was placed and the method or methods used in introducing it into the hole. If cement or other plugs were used, state the character of same and depth placed, from _____ feet to _____ feet for each plug set.

Filled hole with mud to 435'. Set 1st plug w/20
sacks cement. Filled w/mud to 180'. Set 2nd plug
w/20 sacks cement. Filled hole w/mud to 40', set
3rd plug w/10 sacks cement.

RECEIVED
STATE CORPORATION COMMISSION
4-6-61
APR 6 1961

CONSERVATION DIVISION
Wichita, Kansas

(If additional description is necessary, use BACK of this sheet)
Name of Plugging Contractor Hellar Drilling Company, Inc.
Address 1014 Union Center, Wichita, Kansas

STATE OF KANSAS, COUNTY OF SEDGWICK, ss.

D. L. Hellar (employee of owner ~~owner~~) of the above-described well, being first duly sworn on oath, says: That I have knowledge of the facts, statements, and matters herein contained and the log of the above-described well as filed and that the same are true and correct. So help me God.

(Signature) _____

1014 Union Center
(Address)

SUBSCRIBED AND SWORN TO before me this 4th day of April, 19 61

My commission expires March 6, 1965

Martha Lou Bruce
Notary Public.

WELL LOG

15-135-00163-0000

OWNER:
LEASE:
LOCATION:

COMMENCED:
COMPLETED:
CASING:

Hellar Drilling Company, Inc.
Gibson #1
C SE SE, Section 7-20S-25W
Ness County, Kansas
March 17, 1961
March 31, 1961
Set 8 5/8" surface casing
@ 438' w/275 sacks cement

0 - 70	Shale
70 - 438	Shale, shells, sand
438 - 525	Shale
525 - 950	Shale, red bed
950 - 1112	Shale, shells
1112 - 1135	Anhydrite
1135 - 1350	Shale, sand
1350 - 2080	Shale, red bed
2080 - 2290	Shale, shells
2290 - 2485	Shale, lime
2485 - 2800	Lime, shale
2800 - 2818	Shale, lime
2818 - 3736	Lime, Shale
3736 - 3915	Chalky lime, shale
3915 - 3965	Lime
3965 - 4015	Lime, shale breaks
4015 - 4565	Lime
4565	Rotary Total Depth
	D & A

Elevation	KB	2483
Heebner	3846	-1363
Toronto	3868	-1385
Lansing-Kansas City	3892	-1409
Base LKC	4250	-1767
Cherokee	4409	-1926
Mississippian	4508	-2025

RECEIVED
STATE COMPLETION COMMISSION

APR 6 1961
CONSERVATION DIVISION
Wichita, Kansas

STATE OF KANSAS)
) SS:
COUNTY OF SEDGWICK)

I, D. L. Hellar, do hereby certify that the above and foregoing is a true and correct copy of the log of the GIBSON #1, located in the C SE SE, Section 7-20S-25W, Ness County, Kansas, as reflected by the files of the Hellar Drilling Company, Inc.

HELLAR DRILLING COMPANY, INC.

BY *D. L. Hellar*
D. L. Hellar, President

Subscribed and sworn to before me, a Notary Public, in and for Sedgwick County, Kansas, this 4th day of April, 1961.

Manda Lou Bruce
Notary Public

My Commission expires March 6, 1965.