

STATE OF KANSAS  
STATE CORPORATION COMMISSION

WELL PLUGGING RECORD

Give All Information Completely  
Make Required Affidavit  
Mail or Deliver Report to  
Conservation Division  
State Corporation Comm.  
245 North Water  
Wichita, KS 67202

Rush County, Sec. 28 Twp. 19S Rge. 20W ~~E/W~~  
Location as "NE/CNW $\frac{1}{4}$ SW $\frac{1}{4}$ " or footage from lines  
NW/4 NW/4 NW/4

Lease Owner Roy R. Krueger  
Lease Name Miller Well No. 1


Office Address 310 South Main, Russell, Kansas 67665  
Character of Well (Completed as Oil, Gas or Dry Hole) \_\_\_\_\_  
D & A

Date Well completed October 19, 1978  
Application for plugging filed October 19, 1978  
Application for plugging approved October 19, 1978  
Plugging commenced October 19, 1978  
Plugging completed October 19, 1978  
Reason for abandonment of well or producing formation \_\_\_\_\_  
D & A

If a producing well is abandoned, date of last production  
19 \_\_\_\_\_

Was permission obtained from the Conservation Division or  
its agents before plugging was commenced? Yes

Name of Conservation Agent who supervised plugging of this well Leo F. Massey  
Producing formation \_\_\_\_\_ Depth to top \_\_\_\_\_ Bottom \_\_\_\_\_ Total Depth of Well 4,413'  
Show depth and thickness of all water, oil and gas formations.

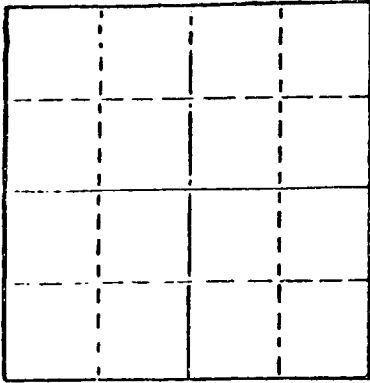

Locate well correctly on above  
Section Plat

OIL, GAS OR WATER RECORDS

CASING RECORD

FORMATION	CONTENT	FROM	TO	SIZE	PUT IN	PULLED OUT
				8 5/8"	307.33'	-0-

Describe in detail the manner in which the well was plugged, indicating where the mud fluid was placed and the method or methods used in introducing it into the hold. If cement or other plugs were used, state the character of same and depth placed, from \_\_\_\_\_ feet to \_\_\_\_\_ feet for each plug set.

Plug @ 550' w/70 sx cement  
Plug @ 300' w/20 sx cement  
Plug @ 40' w/solid bridge & 10 sx cement

STATE RECEIVED  
OCT 26 1978

(If additional description is necessary, use BACK of this sheet)

Name of Plugging Contractor Red Tiger Drilling Company

STATE OF Kansas COUNTY OF Sedgwick, ss. contractor  
Gloria Fawcett (employee of ~~owner~~)

of the above-described well, being first duly sworn on oath, says: That I have knowledge of the facts, statements, and matters herein contained and the log of the above-described well as filed and that the same are true and correct. So help me God.

(Signature) Gloria Fawcett  
1720 KSB&T Building, Wichita, Kansas 67202  
(Address)

SUBSCRIBED AND SWORN TO before me this 23rd day of October, 1978.

My commission expires \_\_\_\_\_

Joyce A. Hagermann  
Notary Public.

