


STATE OF KANSAS
STATE CORPORATION COMMISSION

Give All Information Completely
Make Required Affidavit
Mail or Deliver Report to:
Conservation Division
State Corporation Commission
P. O. Box 17027
Wichita, Kansas 67217
NORTH

WELL PLUGGING RECORD

Ness County, Sec. 2 Twp. 16S Rge. 26W (XXXXXXXXXX)

Location as "NE/CNW/SW" or footage from lines C SE NE
Lease Owner Donald C. Slawson
Lease Name Brown 'X' Well No. 1
Office Address 200 Douglas Building Wichita, Kansas 67202
Character of Well (completed as Oil, Gas or Dry Hole) Dry Hole
Date well completed December 22, 1978
Application for plugging filed December 22, 1978
Application for plugging approved December 22, 1978
Plugging commenced December 22, 1978
Plugging completed December 22, 1978
Reason for abandonment of well or producing formation Dry Hole

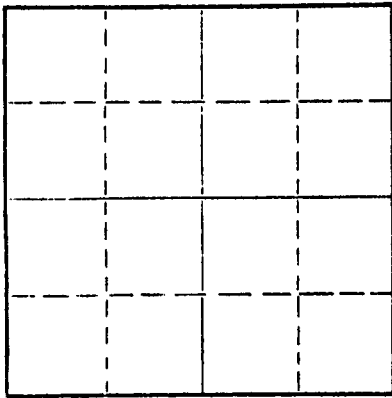

Locate well correctly on above Section Plat

If a producing well is abandoned, date of last production 19
Was permission obtained from the Conservation Division or its agents before plugging was commenced? Yes.

Name of Conservation Agent who supervised plugging of this well Leo F. Massey
Producing formation _____ Depth to top _____ Bottom _____ Total Depth of Well 4245 Feet
Show depth and thickness of all water, oil and gas formations.

OIL, GAS OR WATER RECORDS

CASING RECORD

FORMATION	CONTENT	FROM	TO	SIZE	PUT IN	PULLED OUT
	282.26'	surface	290'	8 5/8"		

Describe in detail the manner in which the well was plugged, indicating where the mud fluid was placed and the method or methods used in introducing it into the hole. If cement or other plugs were used, state the character of same and depth placed, from _____ feet to _____ feet for each plug set.

1st plug @ 800' w/70 sx
2nd plug @ 240' w/20 sx
solid bridge @ 40' w/10 sx
2 sx in rat hole

RECEIVED
STATE CORPORATION COMMISSION

MAR - 7 1979
3-7-79
CONSERVATION DIVISION
Wichita, Kansas


(If additional description is necessary, use BACK of this sheet)
Name of Plugging Contractor Slawson Drilling Co., Inc.
Address 200 Douglas Building Wichita, Kansas 67202

STATE OF Kansas, COUNTY OF Sedgwick, ss.
R. J. THATCHER (employee of owner) or (owner or operator) of the above-described well, being first duly sworn on oath, says: That I have knowledge of the facts, statements, and matters herein contained and the log of the above-described well as filed and that the same are true and correct. So help me God.

(Signature) R. J. Thatcher
R. J. THATCHER 200 Douglas Building
Wichita, Kansas 67202

SUBSCRIBED AND SWORN to before me this 28th day of February, 1979
Sherry L. Milford
Sherry L. Milford Notary Public.

My commission expires 6/12/82

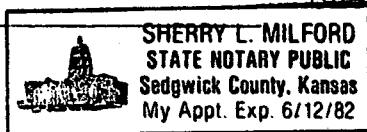

WELL LOG

OPERATOR: DONALD C. SLAWSON
 200 Douglas Building
 Wichita, Kansas 67202

LEASE: #1 Brown 'X'
 C SE NE Sec. 2-16-26W
 Ness County, Kansas

CONTRACTOR: Slawson Drilling Co., Inc.
 200 Douglas Building
 Wichita, Kansas 67202

COMMENCED: December 13, 1978

COMPLETED: December 22, 1978

CASING: Surface - 8 5/8" @ 290' w/200 sx 60/40 poz

0 - 180 Sand, clay, shale & post rock limestone
 180 - 840 Shale
 840 - 985 Sand (Dakota)
 985 - 1360 Shale and sand
 1360 - 1470 Shale
 1470 - 1741 Sand
 1741 - 1986 Shale
 1986 - 2021 Anhydrite
 2021 - 2700 Shale and shells
 2700 - 3920 Shale and lime
 3920 - 4360 Lime
 4360 - 4470 Lime and shale
 4470 - 4506 Lime
 4506 - 4560 Mississippi
 4560 RTD

STATE OF KANSAS)
) SS.
 COUNTY OF SEDGWICK)

I, R.J. Thatcher, of the Slawson Drilling Co., Inc. do hereby swear and state that the above and foregoing is a true and correct copy of the log of the #1 Brown 'X' test.

RECEIVED
 STATE CORPORATION COMMISSION
 MAR - 7 1979
 CONSERVATION DIVISION
 Wichita, Kansas

R. J. Thatcher
 R. J. THATCHER

Subscribed and sworn to before me this 28th day of February, 1979.

Sherry L. Milford
 Sherry L. Milford, Notary Public

My Commission Expires: 6/12/82

