


15-135-20812-6000

STATE OF KANSAS  
STATE CORPORATION COMMISSION

Form CP-4

WELL PLUGGING RECORD

Give All Information Completely  
Make Required Affidavit  
Mail or Deliver Report to:  
Conservation Division  
State Corporation Commission  
P. O. Box 17027  
Wichita, Kansas 67217  
NORTH

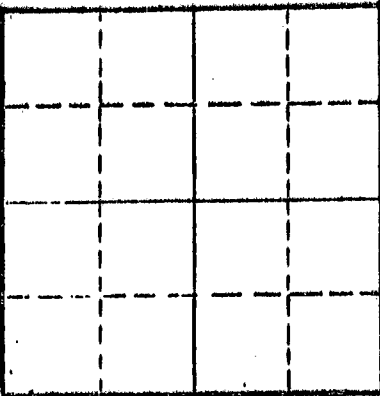

Locate well correctly on above  
Section Plat

Ness County, Sec. 3 Twp. 16S Rge. 26W (E) (W)  
Location as "NE/CNW/SW" or footage from lines SW SE NW  
Lease Owner Donald C. Slawson  
Lease Name Thornburg 'D' Well No. 1  
Office Address 408 120 Bldg., Wichita, Kansas 67202  
Character of Well (completed as Oil, Gas or Dry Hole) Dry Hole  
Date well completed November 10, 1973  
Application for plugging filed November 10, 1973  
Application for plugging approved November 10, 1973  
Plugging commenced 19  
Plugging completed 19  
Reason for abandonment of well or producing formation

If a producing well is abandoned, date of last production 19  
Was permission obtained from the Conservation Division or its agents before plugging was commenced? Yes

Name of Conservation Agent who supervised plugging of this well Leo Massey, Hays, Kansas  
Producing formation Depth to top Bottom Total Depth of Well 4077 Feet  
Show depth and thickness of all water, oil and gas formations.

OIL, GAS OR WATER RECORDS

CASING RECORD

FORMATION	CONTENT	FROM	TO	SIZE	PUT IN	PULLED OUT
8 5/8"	Surface Casing			8 5/8"	29 1	

Describe in detail the manner in which the well was plugged, indicating where the mud fluid was placed and the method or methods used in introducing it into the hole. If cement or other plugs were used, state the character of same and depth placed, from feet to feet for each plug set.

1st plug set at 800' w/70 sx  
2nd plug set @ 240' w/20 sx  
3rd plug set @ 40' w/10 sx

RECEIVED  
STATE CORPORATION COMMISSION  
DEC 3 1973  
CONSERVATION DIVISION  
Wichita, Kansas

(If additional description is necessary, use BACK of this sheet)  
Name of Plugging Contractor Slawson Drilling Company, Inc.  
Address 408 120 Bldg., Wichita, Kansas 67202

STATE OF Kansas COUNTY OF Sedgwick  
James C. Remsberg (employee of owner) or (owner or operator) of the above-described well, being first duly sworn on oath, says: That I have knowledge of the facts, statements, and matters herein contained and the log of the above-described well as filed and that the same are true and correct. So help me God.

(Signature) James C. Remsberg  
James C. Remsberg 408 120 Bldg., Wichita, Kansas  
(Address)

Subscribed and sworn to before me this 30th day of November 1973

DOLORES B. COADY  
STATE NOTARY PUBLIC  
My commission expires SEDGWICK COUNTY, KANSAS  
Comm. Expires Mar. 7, 1976

Dolores B. Coady  
Notary Public.

WELL LOG

15-135-20812-0000

COMPANY: Donald C. Slawson  
 408 One Twenty Building  
 Wichita, Kansas 67202

LEASE: Thornburg 'D' #1  
 SW SE NW Sec. 3-16-26W  
 Ness County, Kansas

TOTAL DEPTH: 4077 feet

COMMENCED: November 5, 1973

COMPLETED: November 10, 1973

CONTRACTOR: Slawson Drilling Company, Inc.

CASING: Set 291' of 8 5/8" at 297 feet w/250 sx

0-60	Sand
60-315	Shale
315-1370	Shale & Shells
1370-1462	Blaine Lime
1462-1530	Shale
1530-1763	Sand
1763-2056	Shale
2056-2074	Anhydrite
2074-2424	Shale & Lime
2424-4048	Lime & Shale
4048-4077	Lime
4077	RTD

RECEIVED  
 STATE CORPORATION COMMISSION  
 DEC 3 1973  
 CONSERVATION DIVISION  
 Wichita, Kansas

STATE OF KANSAS )  
 ) SS.  
 COUNTY OF SEDGWICK )

I, JAMES C. REMSBERG, of the Slawson Drilling Company, Inc. upon oath state that the above and foregoing is a true and correct copy of the log of the Thornburg 'D' #1 well.

*James C. Remsberg*  
 JAMES C. REMSBERG

Subscribed and sworn to before me this 30th day of November, 1973.

*Dolores B. Coady*  
 Dolores B. Coady, Notary Public

My Commission Expires:

DOLORES B. COADY  
 STATE NOTARY PUBLIC  
 SEDGWICK COUNTY, KANSAS  
 Comm. Expires Mar. 7, 1976