

STATE OF KANSAS  
STATE CORPORATION COMMISSION


Form CP-4

WELL PLUGGING RECORD

Give All Information Completely  
Make Required Affidavit  
Mail or Deliver Report to:  
Conservation Division  
State Corporation Commission

P. O. Box 17027  
Wichita, Kansas 67217  
NORTH

Ness County. Sec. 8 Twp. 20S Rge. (E) 25 (W)  
C SW SW  
Location as "NE/CNW/SW" or footage from lines  
Lease Owner Petroleum, Inc.  
Lease Name Beck "C" Well No. #1  
Office Address Route 2, Great Bend, Kansas  
Character of Well (completed as Oil, Gas or Dry Hole) Dry Hole  
Date well completed August 19 19 74  
Application for plugging filed (verbally) August 19 19 74  
Application for plugging approved (verbally) August 19 19 74  
Plugging commenced August 19 19 74  
Plugging completed August 19 19 74  
Reason for abandonment of well or producing formation

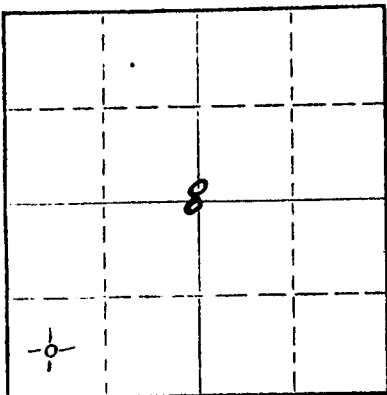

Locate well correctly on above  
Section Flat

If a producing well is abandoned, date of last production 19  
Was permission obtained from the Conservation Division or its agents before plugging was commenced? Yes

Name of Conservation Agent who supervised plugging of this well Leo Massey  
Producing formation Depth to top Bottom Total Depth of Well 4507' Feet  
Show depth and thickness of all water, oil and gas formations.

OIL, GAS OR WATER RECORDS

CASING RECORD

FORMATION	CONTENT	FROM	TO	SIZE	PUT IN	PULLED OUT
				8 5/8"	520'	None

Describe in detail the manner in which the well was plugged, indicating where the mud fluid was placed and the method or methods used in introducing it into the hole. If cement or other plugs were used, state the character of same and depth placed, from feet to feet for each plug set.

1st plug set @535' w/50 sx. cement  
2nd plug set @40' w/10 sx. cement


RECEIVED  
STATE CORPORATION COMMISSION  
AUG 22 1974  
E-22-74  
CONSERVATION DIVISION  
Wichita, Kansas

(If additional description is necessary, use BACK of this sheet)

Name of Plugging Contractor Abercrombie Drilling, Inc.  
Address 801 Union Center

STATE OF KANSAS COUNTY OF SEDGWICK, ss.  
Jerry A. Langrehr (employee of owner) or (owner or operator) of the above-described well, being first duly sworn on oath, says: That I have knowledge of the facts, statements, and matters herein contained and the log of the above-described well as filed and that the same are true and correct. So help me God.

(Signature) *Jerry A. Langrehr*  
801 Union Center, Wichita, Kansas 67201  
(Address)

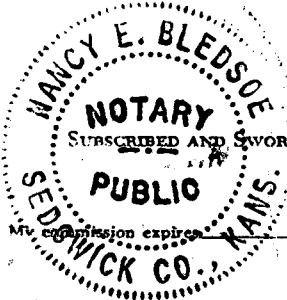

Subscribed and sworn to before me this 21st day of August, 19 74

*Nancy E. Bledsoe*  
Nancy E. Bledsoe Notary Public.

CONTRACTOR'S WELL LOG

15-135-70921-0000

OPERATOR:  
 CONTRACTOR:  
 WELL NAME:  
 LOCATION:  
 GEOLOGIST:  
 SPUD DATE:  
 COMPLETION DATE:

**RECEIVED**  
 STATE CORPORATION COMMISSION  
 AUG 22 1974  
 CONSERVATION DIVISION  
 Wichita, Kansas

Petroleum, Inc.  
 Abercrombie Drilling, Inc.  
 BECK "C" #1  
 C SW SW Sec. 8-20S-25W  
 Ness County, Kansas  
 Jay Dirks  
 August 8, 1974  
 August 19, 1974

0	367	Clay, Sand & Shale
367	523	Sand & Shale
523	1830	Shale
1830	2062	Red Bed & Shale
2062	2083	Anhydrite
2083	2290	Shale
2290	2545	Shale & Lime
2545	3360	Lime & Shale
3360	3490	Lime
3490	3640	Lime & Shale
3640	4495	Lime
4495	4507	Mississippian
	4507	Rotary Total Depth

Drilled 523' of 12 1/4" surface hole. Set 8 5/8" at 520'. Cemented with 275 sacks Common, 2% gel, 3% ca.cl. Cement Circulated. Plug was down @ 6:30 a.m., August 8, 1974.

D & A: 1st Plug set @ 535' with 50 sacks cement.  
 2nd Plug set @ 40' with 10 sacks cement.  
 Plug was down @ 3:00 p.m., August 19, 1974  
 STATE PLUGGER: Leo Massey

<u>SAMPLE TOPS</u>	<u>ELEVATION</u>
Anhydrite 2062 (+393)	2455 K.B.
B/Anhydrite 2083 (#372)	2453 D.F.
	2450 G.L.

STATE OF KANSAS     )  
                                   )   SS  
 COUNTY OF SEDGWICK )

Jerry A. Langrehr, Vice President of Abercrombie Drilling, Inc., does hereby state that the above and foregoing is a true and correct copy of the log of the BECK "C" #1, C SW SW Sec. 8-20S-25W, Ness County, Ks.

ABERCROMBIE DRILLING, INC.

By: Jerry A. Langrehr  
 Jerry A. Langrehr  
 Vice President

Subscribed and sworn to before me a Notary Public, in and for the aforesaid county and state as of this 21st day of August, 1974.

Nancy E. Bledsoe  
 Nancy E. Bledsoe, Notary Public

My Commission Expires: April 8, 1978

