

STATE OF KANSAS  
STATE CORPORATION COMMISSION


WELL PLUGGING RECORD

15135-22307-0000

Give All Information Completely  
Make Required Affidavit  
Mail or Deliver Report to  
Conservation Division  
State Corporation Comm.  
245 North Water  
Wichita, KS 67202

Ness County, Sec. 12 Twp. 16S Rge. 26W E/W  
Location as "NE/CNW/SW" or footage from lines  
NE NE NW

Lease Owner Palomino Petroleum  
Lease Name Nies Well No. 1  
Office Address P. O. Box 18610, Wichita, Kansas 67218  
Character of Well (Completed as Oil, Gas or Dry Hole)

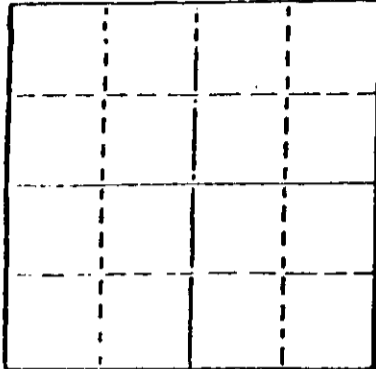

Locate well correctly on above Section Plat

Dry Hole  
Date Well completed October 18, 19 82  
Application for plugging filed October 18, 19 82  
Application for plugging approved October 18, 19 82  
Plugging commenced October 18, 19 82  
Plugging completed October 18, 19 82  
Reason for abandonment of well or producing formation  
Dry Hole

If a producing well is abandoned, date of last production 19

Was permission obtained from the Conservation Division or its agents before plugging was commenced? Yes

Name of Conservation Agent who supervised plugging of this well Tarbottom  
Producing formation \_\_\_\_\_ Depth to top \_\_\_\_\_ Bottom \_\_\_\_\_ Total Depth of Well \_\_\_\_\_  
Show depth and thickness of all water, oil and gas formations.

OIL, GAS OR WATER RECORDS					CASING RECORD	
FORMATION	CONTENT	FROM	TO	SIZE	PUT IN	PULLED OUT

Describe in detail the manner in which the well was plugged, indicating where the mud fluid was placed and the method or methods used in introducing it into the hold. If cement or other plugs were used, state the character of same and depth placed, from \_\_\_\_\_ feet to \_\_\_\_\_ feet for each plug set.

Plugged : @ 1200' w/ 70 sks  
330' w/ 40 sks  
40' Hulls & Plug w/ 10 sks  
10 sks Rat hole  
10 sks Mouse Hole  
Cement: 50-50 Pozmix, 4% Gel, 3% CC

(If additional description is necessary, use BACK of this sheet)

Name of Plugging Contractor Sun Cement


STATE OF Kansas COUNTY OF Sedgwick, ss.  
Jerome D. Marcus (employee of owner) or (owner or operator)  
of the above-described well, being first duly sworn on oath, says: That I have knowledge of the facts, statements, and matters herein contained and the log of the above-described well as filed and that the same are true and correct. So help me God.

(Signature) *[Signature]*  
401 E. Douglas, Suite 402, Wichita, Kansas 67202  
(Address)

SUBSCRIBED AND SWORN TO before me this 28th day of October, 1982

My commission expires June 8, 1985

*[Signature]*  
Notary Public.  
STATE CORPORATION COMMISSION

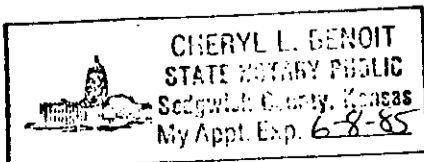

DEC 3 1982  
12-3-82  
CONSERVATION DIVISION  
Wichita Kansas