


STATE OF KANSAS
STATE CORPORATION COMMISSION

WELL PLUGGING RECORD

Give All Information Completely
Make Required Affidavit
Mail or Deliver Report to:
Conservation Division
State Corporation Commission
211 No. Broadway
Wichita, Kansas

Ness County. Sec. 18 Twp. 16 Rge. 26 (XXXXX(W))

Location as "NE/CNW/SW" or footage from lines C NW NW
Lease Owner Shell Oil Company
Lease Name Norton Well No. 2-18
Office Address 1200 First Natl. Bank Bldg., Oklahoma City, Oklahoma
Character of Well (completed as Oil, Gas or Dry Hole) Dry Hole
Date well completed March 3 19 66
Application for plugging filed March 3 19 66
Application for plugging approved March 3 19 66
Plugging commenced March 3 19 66
Plugging completed March 3 19 66
Reason for abandonment of well or producing formation Dry Hole

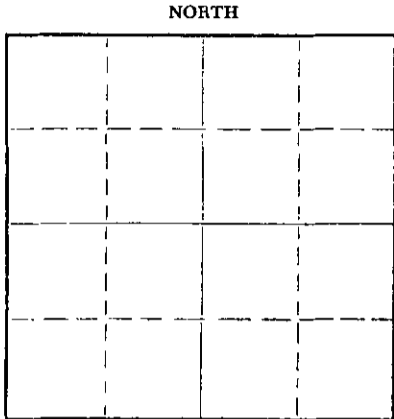

Locate well correctly on above Section Plat

If a producing well is abandoned, date of last production _____ 19____
Was permission obtained from the Conservation Division or its agents before plugging was commenced? yes

Name of Conservation Agent who supervised plugging of this well Gilbert Leiker 805 Main, Victoria, Kansas
Producing formation _____ Depth to top _____ Bottom _____ Total Depth of Well 4571 Feet
Show depth and thickness of all water, oil and gas formations.

OIL, GAS OR WATER RECORDS

CASING RECORD

FORMATION	CONTENT	FROM	TO	SIZE	PUT IN	PULLED OUT
	Surface - Sand - Shale	0	287	9 5/8"	258'	-0-

Describe in detail the manner in which the well was plugged, indicating where the mud fluid was placed and the method or methods used in introducing it into the hole. If cement or other plugs were used, state the character of same and depth placed, from _____ feet to _____ feet for each plug set.

Plug set at 600' with 20 sacks cement.
Plug set at 240' with 20 sacks cement.
Plug set at 40' with 10 sacks cement.

RECEIVED
STATE CORPORATION COMMISSION

MAR 16 1966
3-16-66
CONSERVATION DIVISION
Wichita, Kansas

(If additional description is necessary, use BACK of this sheet)
Name of Plugging Contractor Empire Drilling Company
Address 650 Fourth Natl. Bank Bldg., Wichita, Kansas 67202

STATE OF KANSAS COUNTY OF SEDGWICK, ss. Theodore Gore contractor
(employer of Kansas) or (owner of property) of the above-described well, being first duly sworn on oath, says: That I have knowledge of the facts, statements, and matters herein contained and the log of the above-described well as filed and that the same are true and correct. So help me God.

(Signature) Theodore Gore
650 4th Natl. Bank Bldg., Wichita, Ks. 67202
(Address)

SUBSCRIBED AND SWORN to before me this 9th day of March, 19 66

Sandra Kay Peer
Sandra Kay Peer Notary Public.

My commission expires September 14, 1968

L O G

15:135-30183-0000

COMPANY: Shell Oil Company
 CONTRACTOR: Empire Drilling Company
 FARM: Norton #2-18
 LOCATION: C NW NW Section 18-16-26W, Ness County, Kansas
 COMMENCED: February 18, 1966 ELEVATION: 2660 KB
 COMPLETED: March 3, 1966 POTENTIAL: D & A

0	to	287	Surface - Sand - Shale
287	to	1390	Shale - Shells
1390	to	1870	Shale & Sand
1870	to	2051	Redbed
2051	to	2087	Anhydrite
2087	to	2330	Shale
2330	to	2525	Shale & Salt
2525	to	2860	Lime & Shale
2860	to	2940	Lime
2940	to	3015	Lime & Shale
3015	to	3070	Lime
3070	to	3890	Lime - Shale
3890	to	4060	Lime & Chert
4060	to	4490	Lime & Shale
4490	to	4550	Lime & Chert
4550	to	4552	Mississippi Lime
4552	to	4571	Mississippi
4571			Rotary Total Depth

Set: 258' of 9 5/8" with 135 sacks cement.

SCHLUMBERGER ELECTRIC LOG TOPS:

Waubensee Group	3481	-821
Shawnee Group	3673	-1013
Queen Hill	3758	-1098
Heebner	3895	-1235
Toronto	3915	-1255
Lansing	3935	-1275
Muncie Creek Shale	4086	-1426
Base Kansas City	4241	-1581
Pawnee	4326	-1666
Fort Scott	4381	-1721
Cherokee Group	4431	-1771
Conglomerate	4516	-1856
Mississippi	4548	-1888
Log Total Depth	4571	

RECEIVED
 STATE CORPORATION COMMISSION
 MAR 16 1966
 CONSERVATION DIVISION
 Topeka, Kansas

CERTIFICATION

I, Theodore Gore, do hereby certify that the above and foregoing is a true and correct copy of the log on the Norton #2-18, C NW NW Section 18-16-26W, Ness County, Kansas, as reflected by the files of Empire Drilling Company.

Theodore Gore
 Theodore Gore

Subscribed and sworn to before me, a Notary Public, within and for Sedgwick County, Kansas, this 9th day of March, 1966.

Sandra Kay Peer
 Sandra Kay Peer, Notary Public

My commission expires September 14, 1968.