

This form shall be filed in duplicate with the Kansas Corporation Commission, 200 Colorado Derby Building, Wichita, Kansas 67202, within ten days after the completion of the well, regardless of how the well was completed.

Attach separate letter of request if the information is to be held confidential. If confidential, only file one copy. Information on side one will be of public record and side two will then be held confidential.

Circle one: Oil, Gas, Dry, SWD, OWWO, Injection. Type and complete ALL sections. Applications must be filed for dual completion, commingling, SWD and injection, T.A.

Attach wireline logs (i.e. electrical log, sonic log, gamma ray neutron log, etc.). KCC # (316) 263-3238. (Rules 82-2-105 & 82-2-125)

OPERATOR ZENITH DRILLING CORPORATION

API NO. 15-135-22,145 - 0000

ADDRESS 505 Fourth Financial Center

COUNTY Ness

Wichita, Kansas 67202

FIELD X-Wildcat CARLSON

**CONTACT PERSON Sherrill Compton

PROD. FORMATION Mississippi

PHONE (316) 265-6697

LEASE Carlson

PURCHASER Inland

WELL NO. 1

ADDRESS Wichita, Kansas

WELL LOCATION SW SW NW

DRILLING Abercrombie Drilling, Inc.

330 Ft. from West Line and

CONTRACTOR

330 Ft. from South Line of

ADDRESS 801 Union Center

the NW/4 SEC. 17 TWP. 16 RGE. 26W


Wichita, Kansas 67202

WELL PLAT

PLUGGING Abercrombie Drilling, Inc.

CONTRACTOR

ADDRESS 801 Union Center

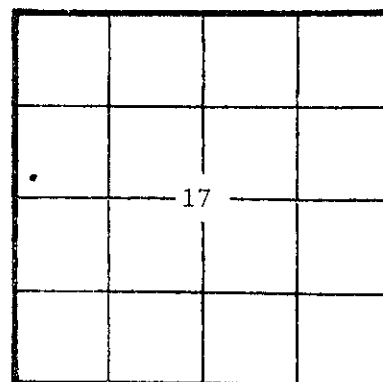

KCC [check]
KGS [check]
(Office Use)

Wichita, Ks. 67202

TOTAL DEPTH 4630' PBD N/A

SPUD DATE 10-19-81 DATE COMPLETED 10-29-81

ELEV: GR 2641' DF 2649' KB 2646'

DRILLED WITH (CABLE) (ROTARY) (AIR) TOOLS

Amount of surface pipe set and cemented 324.64'/200 sacks. DV Tool Used? None

A F F I D A V I T

STATE OF KANSAS, COUNTY OF SEDGWICK SS, I,

Sherrill Compton OF LAWFUL AGE, BEING FIRST DULY SWORN UPON HIS OATH,

DEPOSES THAT HE IS Vice President (OF) Zenith Drilling Corporation

OPERATOR OF THE Carlson LEASE, AND IS DULY AUTHORIZED TO MAKE

THIS AFFIDAVIT FOR AND ON THE BEHALF OF SAID OPERATOR, THAT WELL NO. 1 ON

SAID LEASE HAS BEEN COMPLETED AS OF THE 29th DAY OF October, 19 81, AND THAT

ALL INFORMATION ENTERED HEREIN WITH RESPECT TO SAID WELL IS TRUE AND CORRECT.

FURTHER AFFIANT SAITH NOT.

(S) Sherrill Compton
Sherrill Compton

SUBSCRIBED AND SWORN BEFORE ME THIS 11th DAY OF December, 1981

Sharon R. Allen
NOTARY PUBLIC
Sharon R. Allen

MY COMMISSION EXPIRES: December 15, 1984

**The person who can be reached by phone regarding any questions concerning this information. Within 45 days of completion, a witnessed initial test by the Commission is required if the well produces more than 25 BOPD or is located in a Basic Pool.

RECEIVED
STATE CORPORATION COMMISSION
DEC 14 1981
12-14-81
CONSERVATION DIVISION
Wichita, Kansas